


- ### BUILDING SETBACK
- DIMENSIONS SHOWN APPLY TO SINGLE STOREY (4.5m HIGH OR LESS) CLASS 1 BUILDINGS ONLY. THE PROVISIONS OF THE QUEENSLAND DEVELOPMENT CODE (QDC) OTHERWISE APPLY TO CLASS 1 TWO STOREY (4.5m HIGH OR MORE) BUILDINGS.
 - THE PROVISIONS OF THE QDC APPLY FOR CLASS 10A BUILDINGS AND CLASS 10B STRUCTURES. EXCEPTING THAT DETACHED CARPORTS AND SHEDS SHALL NOT BE CONSTRUCTED FORWARD OF THE BUILDING ENVELOPE ALIGNMENT TO THE STREET FRONTAGE AND SHALL NOT BE CONSTRUCTED FORWARD OF THE MAIN BUILDING LINE OF THE DWELLING HOUSE.
 - ALL SETBACK DISTANCES ARE TAKEN FROM THE OUTERMOST PROJECTION AS DEFINED BY THE QDC.
 - ALL SETBACKS SHOWN ARE MINIMUM DISTANCES AND MAY VARY TO ACCOMMODATE THE ZONE OF INFLUENCE OF UNDERGROUND SERVICES AS STATED IN COUNCIL'S POLICY ON BUILDING OVER OR ADJACENT TO SEWERAGE SERVICES. ACTUAL SETBACKS SHALL BE CONFIRMED FROM THE AS CONSTRUCTED SEWER INFORMATION.
 - THE MAXIMUM LENGTH OF BUILT-TO-BOUNDARY WALL ON VILLA AND COURTYARD ALLOTMENTS SHALL NOT EXCEED 40% OF THE BOUNDARY LENGTH, WITH A MAXIMUM SINGLE WALL SECTION LENGTH NOT EXCEEDING 8.0m. ALL BUILT-TO-BOUNDARY WALL SECTIONS SHALL BE FOR NON-HABITABLE ROOMS ONLY. HABITABLE ROOMS SHALL OTHERWISE ADOPT A MINIMUM SETBACK COMPLIANT WITH SECTION A2 OF MPL1 AND MPL2 OF THE QDC.
 - THE BUILT-TO-BOUNDARY SETBACK SHALL ALLOW FOR THE PROVISION OF FIXED GUTTERING TO THE DWELLING FASCIA WHICH SHALL BE CONNECTED TO A PIPED UNDERGROUND STORMWATER DRAINAGE SYSTEM DISCHARGING TO THE STREET FRONTAGE.
 - SETBACKS ON CORNER ALLOTMENTS SHALL ADOPT A MINIMUM 9.0m X 9.0m TRUNCATION PURSUANT TO THE QDC.
 - ALLOWABLE DRIVEWAY ACCESS LOCATIONS ARE SHOWN INDICATIVELY AND ACTUAL LOCATIONS SHALL BE CLEAR OF ALL APPURTENANCES VIZ. PILLAR BOX, SERVICE PITS, LOT WATER OFF-TAKES AND SUBSOIL FLUSH POINTS IN ACCORDANCE WITH COUNCIL STANDARDS.

- ### CLIMATICALLY RESPONSIVE BUILDING DESIGN
- ALLOTMENTS ALLOCATED A BUILT-TO-BOUNDARY SETBACK SHALL BE TYPICALLY DESIGNED AND LOCATED SUCH THAT THE BUILT-TO-BOUNDARY WALL IS LOCATED ON THE WESTERN OR SOUTHERN ORIENTATED BOUNDARY TO MAXIMISE THE PREVAILING BREEZE AND SOLAR ORIENTATION ON THE ALTERNATE BOUNDARY.
 - THE FOLLOWING DESIGN PARAMETERS SHOULD BE CONSIDERED DURING THE DESIGN PHASE OF PROPOSED DWELLINGS:
 - A BUILDING ORIENTATION THAT MINIMISES THE LENGTH OF EXTERNAL WALL AREAS THAT ARE EXPOSED TO SOLAR RADIATION;
 - AN INTERNAL LAYOUT THAT ENSURES THE LIVING AREAS ARE PROTECTED FROM SUMMER SOLAR RADIATION (IE, LIVING AREAS ORIENTATED NORTH TO NORTH-EAST AND SERVICE AREAS ARE ORIENTATED TO THE WEST AND SOUTH);
 - BUILDING PROJECTIONS ARE USED TO MINIMISE SUMMER SOLAR RADIATION TO EXTERNAL WALLS (IE, CARPORTS, LARGE OVERHANGS AND EXTERNAL SCREENS) AND ARE INCORPORATED TO FULLY SHADE WESTERN AND SOUTH-WEST FACING EXTERNAL WALLS, AND
 - A BUILDING LAYOUT THAT MAXIMISES THE CAPTURE OF PREVAILING BREEZES (LIVING AREA WINDOWS AND DOORS ARE ORIENTATED TO THE NORTH-EAST AND ROOM LAYOUTS AND INTERNAL ACCESS WAYS ARE DESIGNED TO MAXIMISE CROSS VENTILATION).

LEGEND

- BUILDING ENVELOPE
- PREMIUM TRADITIONAL, TRADITIONAL, ECONOMY TRADITIONAL, COURTYARD AND VILLA ALLOTMENT
- BUILT-TO-BOUNDARY LINE
- ALLOWABLE DRIVEWAY ACCESS
- BUILDING ENVELOPE CUT-OUT 1.5m x 2.0m
- BUILDING ENVELOPE CUT-OUT 1.5m x 2.5m
- BUILDING ENVELOPE CUT-OUT 1.5m x 3.0m
- BUILDING ENVELOPE CUT-OUT 1.5m x 3.5m

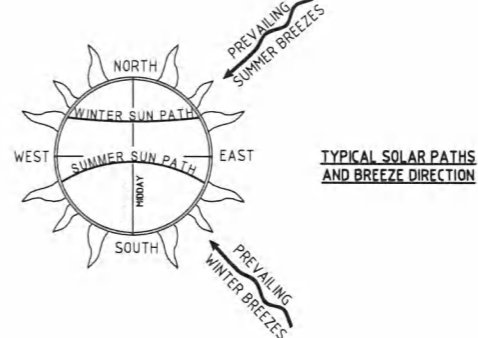

AS CONSTRUCTED CERTIFICATION


THE WORK ON THIS DRAWING HAS BEEN CONSTRUCTED GENERALLY IN ACCORDANCE WITH THE DESIGN DRAWINGS AND THE INTENT OF THE GUIDELINES OF TOWNSVILLE CITY COUNCIL

APPROVED: *Cheryl Helm* RPEQ: 12732
for and on behalf of Empower Engineer & Project Managers



1	AS CONSTRUCTED	JT	JK	CH	<i>Cheryl Helm</i>	12732	17/03/17
No.	Amendments	Drawn	Design	Appd	Registered Engineer	Reg No.	Date

This drawing cannot be copied or reproduced in any form or used for any purpose other than that originally intended without the written permission of Empower Engineers and Project Managers © COPYRIGHT 2017

Client	URBEX PTY LTD	Datum	AHD
Project	KALYNDIA CHASE STAGE 11B3 AND 11C1	PSM NO.	131651
Title	ACCESS AND BUILDING ENVELOPE PLAN SHEET 1 OF 4	RL	19.248M (MGA) COORD
		AS CONSTRUCTED	
		Project No.	Drawing No.
		CT1521-ABEP101	1

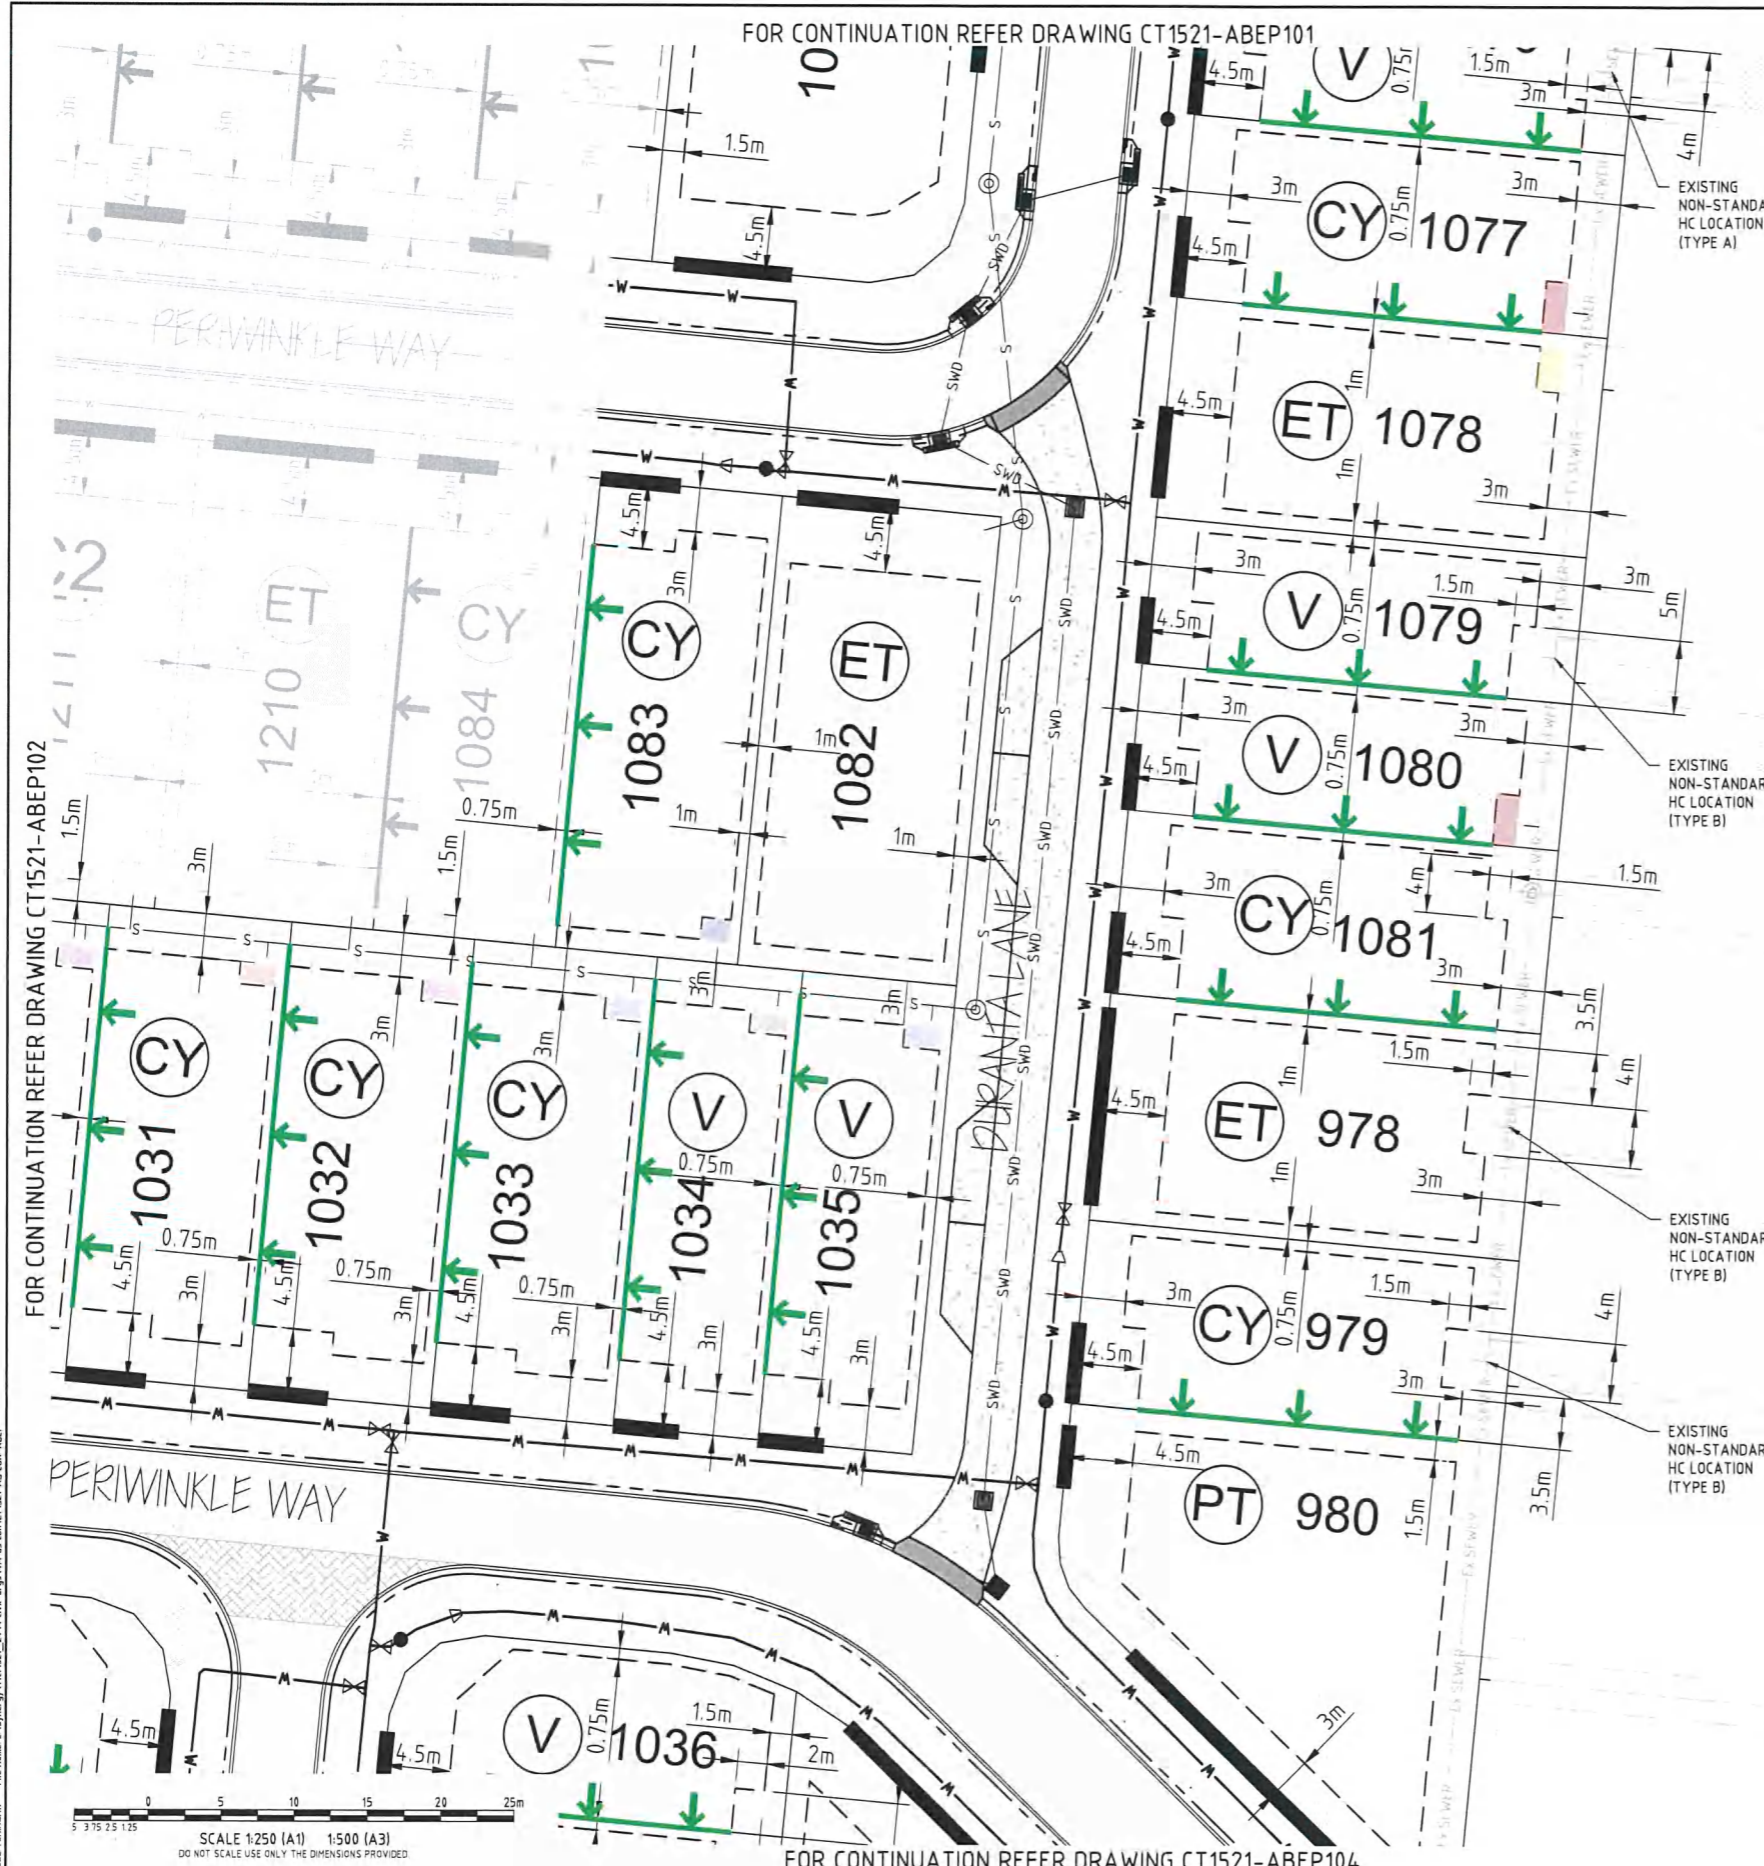

EXISTING STAGE 11A

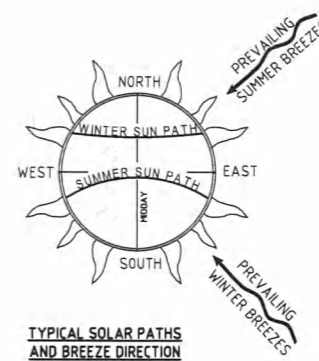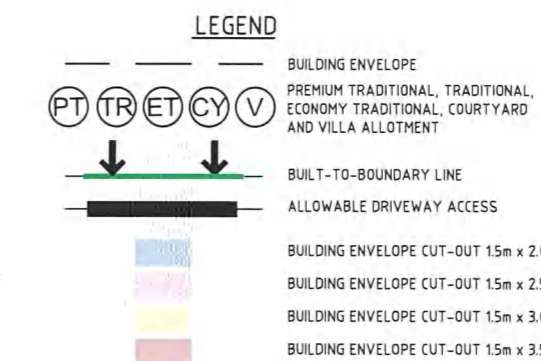

- BUILDING SETBACK**
- DIMENSIONS SHOWN APPLY TO SINGLE STOREY (4.5m HIGH OR LESS) CLASS 1 BUILDINGS ONLY. THE PROVISIONS OF THE QUEENSLAND DEVELOPMENT CODE (QDC) OTHERWISE APPLY TO CLASS 1 TWO STOREY (4.5m HIGH OR MORE) BUILDINGS.
 - THE PROVISIONS OF THE QDC APPLY FOR CLASS 10A BUILDINGS AND CLASS 10B STRUCTURES. EXCEPTING THAT DETACHED CARPORTS AND SHEDS SHALL NOT BE CONSTRUCTED FORWARD OF THE BUILDING ENVELOPE ALIGNMENT TO THE STREET FRONTAGE AND SHALL NOT BE CONSTRUCTED FORWARD OF THE MAIN BUILDING LINE OF THE DWELLING HOUSE.
 - ALL SETBACK DISTANCES ARE TAKEN FROM THE OUTERMOST PROJECTION AS DEFINED BY THE QDC.
 - ALL SETBACKS SHOWN ARE MINIMUM DISTANCES AND MAY VARY TO ACCOMMODATE THE ZONE OF INFLUENCE OF UNDERGROUND SERVICES AS STATED IN COUNCIL'S POLICY ON BUILDING OVER OR ADJACENT TO SEWERAGE SERVICES. ACTUAL SETBACKS SHALL BE CONFIRMED FROM THE AS CONSTRUCTED SEWER INFORMATION.
 - THE MAXIMUM LENGTH OF BUILT-TO-BOUNDARY WALL ON VILLA AND COURTYARD ALLOTMENTS SHALL NOT EXCEED 40% OF THE BOUNDARY LENGTH, WITH A MAXIMUM SINGLE WALL SECTION LENGTH NOT EXCEEDING 8.0m. ALL BUILT-TO-BOUNDARY WALL SECTIONS SHALL BE FOR NON-HABITABLE ROOMS ONLY. HABITABLE ROOMS SHALL OTHERWISE ADOPT A MINIMUM SETBACK COMPLIANT WITH SECTION A2 OF MP1.1 AND MP1.2 OF THE QDC.
 - THE BUILT-TO-BOUNDARY SETBACK SHALL ALLOW FOR THE PROVISION OF FIXED GUTTERING TO THE DWELLING FASCIA WHICH SHALL BE CONNECTED TO A PIPED UNDERGROUND STORMWATER DRAINAGE SYSTEM DISCHARGING TO THE STREET FRONTAGE.
 - SETBACKS ON CORNER ALLOTMENTS SHALL ADOPT A MINIMUM 9.0m x 9.0m TRUNCATION PURSUANT TO THE QDC.
 - ALLOWABLE DRIVEWAY ACCESS LOCATIONS ARE SHOWN INDICATIVELY AND ACTUAL LOCATIONS SHALL BE CLEAR OF ALL APPURTENANCES VIZ. PILLAR BOX, SERVICE PITS, LOT WATER OFF-TAKES AND SUBSOIL FLUSH POINTS IN ACCORDANCE WITH COUNCIL STANDARDS.

- CLIMATICALLY RESPONSIVE BUILDING DESIGN**
- ALLOTMENTS ALLOCATED A BUILT-TO-BOUNDARY SETBACK SHALL BE TYPICALLY DESIGNED AND LOCATED SUCH THAT THE BUILT-TO-BOUNDARY WALL IS LOCATED ON THE WESTERN OR SOUTHERN ORIENTATED BOUNDARY TO MAXIMISE THE PREVAILING BREEZE AND SOLAR ORIENTATION ON THE ALTERNATE BOUNDARY.
 - THE FOLLOWING DESIGN PARAMETERS SHOULD BE CONSIDERED DURING THE DESIGN PHASE OF PROPOSED DWELLINGS:
 - A BUILDING ORIENTATION THAT MINIMISES THE LENGTH OF EXTERNAL WALL AREAS THAT ARE EXPOSED TO SOLAR RADIATION;
 - AN INTERNAL LAYOUT THAT ENSURES THE LIVING AREAS ARE PROTECTED FROM SUMMER SOLAR RADIATION (IE, LIVING AREAS ORIENTATED NORTH TO NORTH-EAST AND SERVICE AREAS ARE ORIENTATED TO THE WEST AND SOUTH);
 - BUILDING PROJECTIONS ARE USED TO MINIMISE SUMMER SOLAR RADIATION TO EXTERNAL WALLS (IE, CARPORTS, LARGE OVERHANGS AND EXTERNAL SCREENS) AND ARE INCORPORATED TO FULLY SHADE WESTERN AND SOUTH-WEST FACING EXTERNAL WALLS, AND
 - A BUILDING LAYOUT THAT MAXIMISES THE CAPTURE OF PREVAILING BREEZES (LIVING AREA WINDOWS AND DOORS ARE ORIENTATED TO THE NORTH-EAST AND ROOM LAYOUTS AND INTERNAL ACCESS WAYS ARE DESIGNED TO MAXIMISE CROSS VENTILATION).

AS CONSTRUCTED CERTIFICATION

THE WORK ON THIS DRAWING HAS BEEN CONSTRUCTED GENERALLY IN ACCORDANCE WITH THE DESIGN DRAWINGS AND THE INTENT OF THE GUIDELINES OF TOWNSVILLE CITY COUNCIL

APPROVED: *Cheryl Helm* RPEQ 12732

for and on behalf of Empower Engineer & Project Managers

1	AS CONSTRUCTED	JT	JK	CH	<i>Cheryl Helm</i>	12732	17/03/17
No.	Amendments	Drawn	Design	Appd	Registered Engineer	Reg No.	Date

This drawing cannot be copied or reproduced in any form or used for any purpose other than that originally intended without the written permission of Empower Engineers and Project Managers © COPYRIGHT 2017



Client	URBEX PTY LTD	Datum	AHD
Project	KALYNDIA CHASE STAGE 11B3 AND 11C1	PSM NO.	131651
Title	ACCESS AND BUILDING ENVELOPE PLAN SHEET 3 OF 4	RL	19.248M (MGA) COORD
		AS CONSTRUCTED	
		Project No.	CT1521-ABEP103
		Drawing No.	1