


**WATER LEGEND**

- 100 NEW WATER MAIN (Ø100)
- 150 NEW WATER MAIN (Ø150)
- 63 NEW 63 OD POLYETHYLENE LOOP MAIN
- W EXISTING WATER
- STAGE BOUNDARY
- FH FIRE HYDRANT
- SV SLUICE VALVE
- 50GV GATE VALVE
- 50GV TEE
- END CAP

**WATER NOTES**

- 1 ALL WATER MAINS ARE LOCATED 18m ALIGNMENT OFFSET FROM PROPERTY BOUNDARIES UNLESS SHOWN OTHERWISE
- 2 ALL UPVC MAINS ARE SERIES 2, PN16 TO AS/NZS 1477 RUBBER RING JOINTED, WITH SOCKETED D.I.C.L. FITTINGS U.N.O.
- 3 ALL POLYETHYLENE MAINS ARE PN16 TO AS/NZS 4130 WITH FITTINGS TO AS/NZS 4129 UNLESS NOTED OTHERWISE

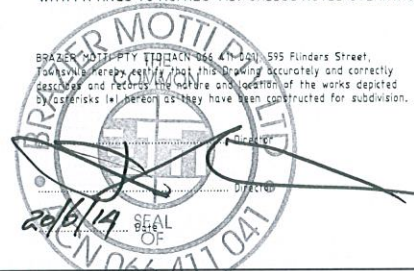

**AS CONSTRUCTED CERTIFICATION**

THE WORK ON THIS DRAWING HAVE BEEN CONSTRUCTED GENERALLY IN ACCORDANCE WITH THE DESIGN DRAWINGS AND THE INTENT OF THE GUIDELINES OF TOWNSVILLE CITY COUNCIL

APPROVED: *Cheryl Wehn* RPEQ: 12732

for and on behalf of BMD Consulting Pty Ltd



User: (BMS)10050000 File Name: B:\Urban\Kalynda\Township\DWG\AS CONSTRUCTED - 19/06/2014.dwg Plot Date: 20/06/2014 10:17:01 AM

No.	As Constructed	JK	JK	MKB	Cheryl Wehn	12732	19/06/14
		Drawn	Design	Appd	Registered Engineer	Reg No.	Date
1	AS CONSTRUCTED						



**BMD consulting**

1st Floor, 57 Mitchell Street North Ward QLD 4810  
 PO Box 8008 Townsville MC QLD 4810  
 P: 07 4750 7000 F: 07 4750 7077  
 E: townsville@bmd.com.au www.bmd.com.au  
 ABN 23 010 743 652

Civil Engineers • Structural Engineers • Project Managers • Water Servicing Co-ordinators  
 Brisbane • Cairns • Canberra • Gladstone • Gold Coast • Mackay • Sydney • Townsville

Client: **URBEX PTY LTD**

Project: **KALYNDA CHASE STAGES 12B2 AND 12B3**

Title: **WATER RETICULATION LAYOUT**

Datum: **AHD**

PSM NO.131651  
 RL 19.248M  
 (MGA) COORD

**AS CONSTRUCTED**

Project No. Drawing No. Rev  
**CT1522-CW101 1**