


AS CONSTRUCTED CERTIFICATION

THE WORK ON THIS DRAWING HAS BEEN CONSTRUCTED GENERALLY IN ACCORDANCE WITH THE DESIGN DRAWINGS AND THE INTENT OF THE GUIDELINES OF TOWNSVILLE CITY COUNCIL

APPROVED: *Cheryl Helm* RPEQ: 12732
 for and on behalf of Empower Engineer & Project Managers 


BRAZIER MOTTI PTY LTD (ACN 066 411 041)
 595 FLINDERS STREET, TOWNSVILLE
 HEREBY CERTIFY THAT THIS DRAWING ACCURATELY AND CORRECTLY DESCRIBES AND RECORDS THE NATURE AND LOCATION OF THE WORKS DEPICTED BY ASTERISKS (*) HEREON AS THEY HAVE BEEN CONSTRUCTED.

DIRECTOR: *[Signature]*







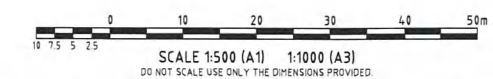


DATE: 27/03/17


NOTE

1. FOR NOTES AND LEGEND REFER CT1521-CW001



WATER LEGEND

-  100 AS CONSTRUCTED WATER MAIN (Ø100 uPVC)
-  150 AS CONSTRUCTED WATER MAIN (Ø150 uPVC)
-  200 AS CONSTRUCTED WATER MAIN (Ø200 uPVC)
-  63 63 OD POLYETHYLENE LOOP MAIN
-  W EXISTING WATER
-  STAGE BOUNDARY
-  FH FIRE HYDRANT
-  SV SLUICE VALVE
-  50GV/63 GATE VALVE

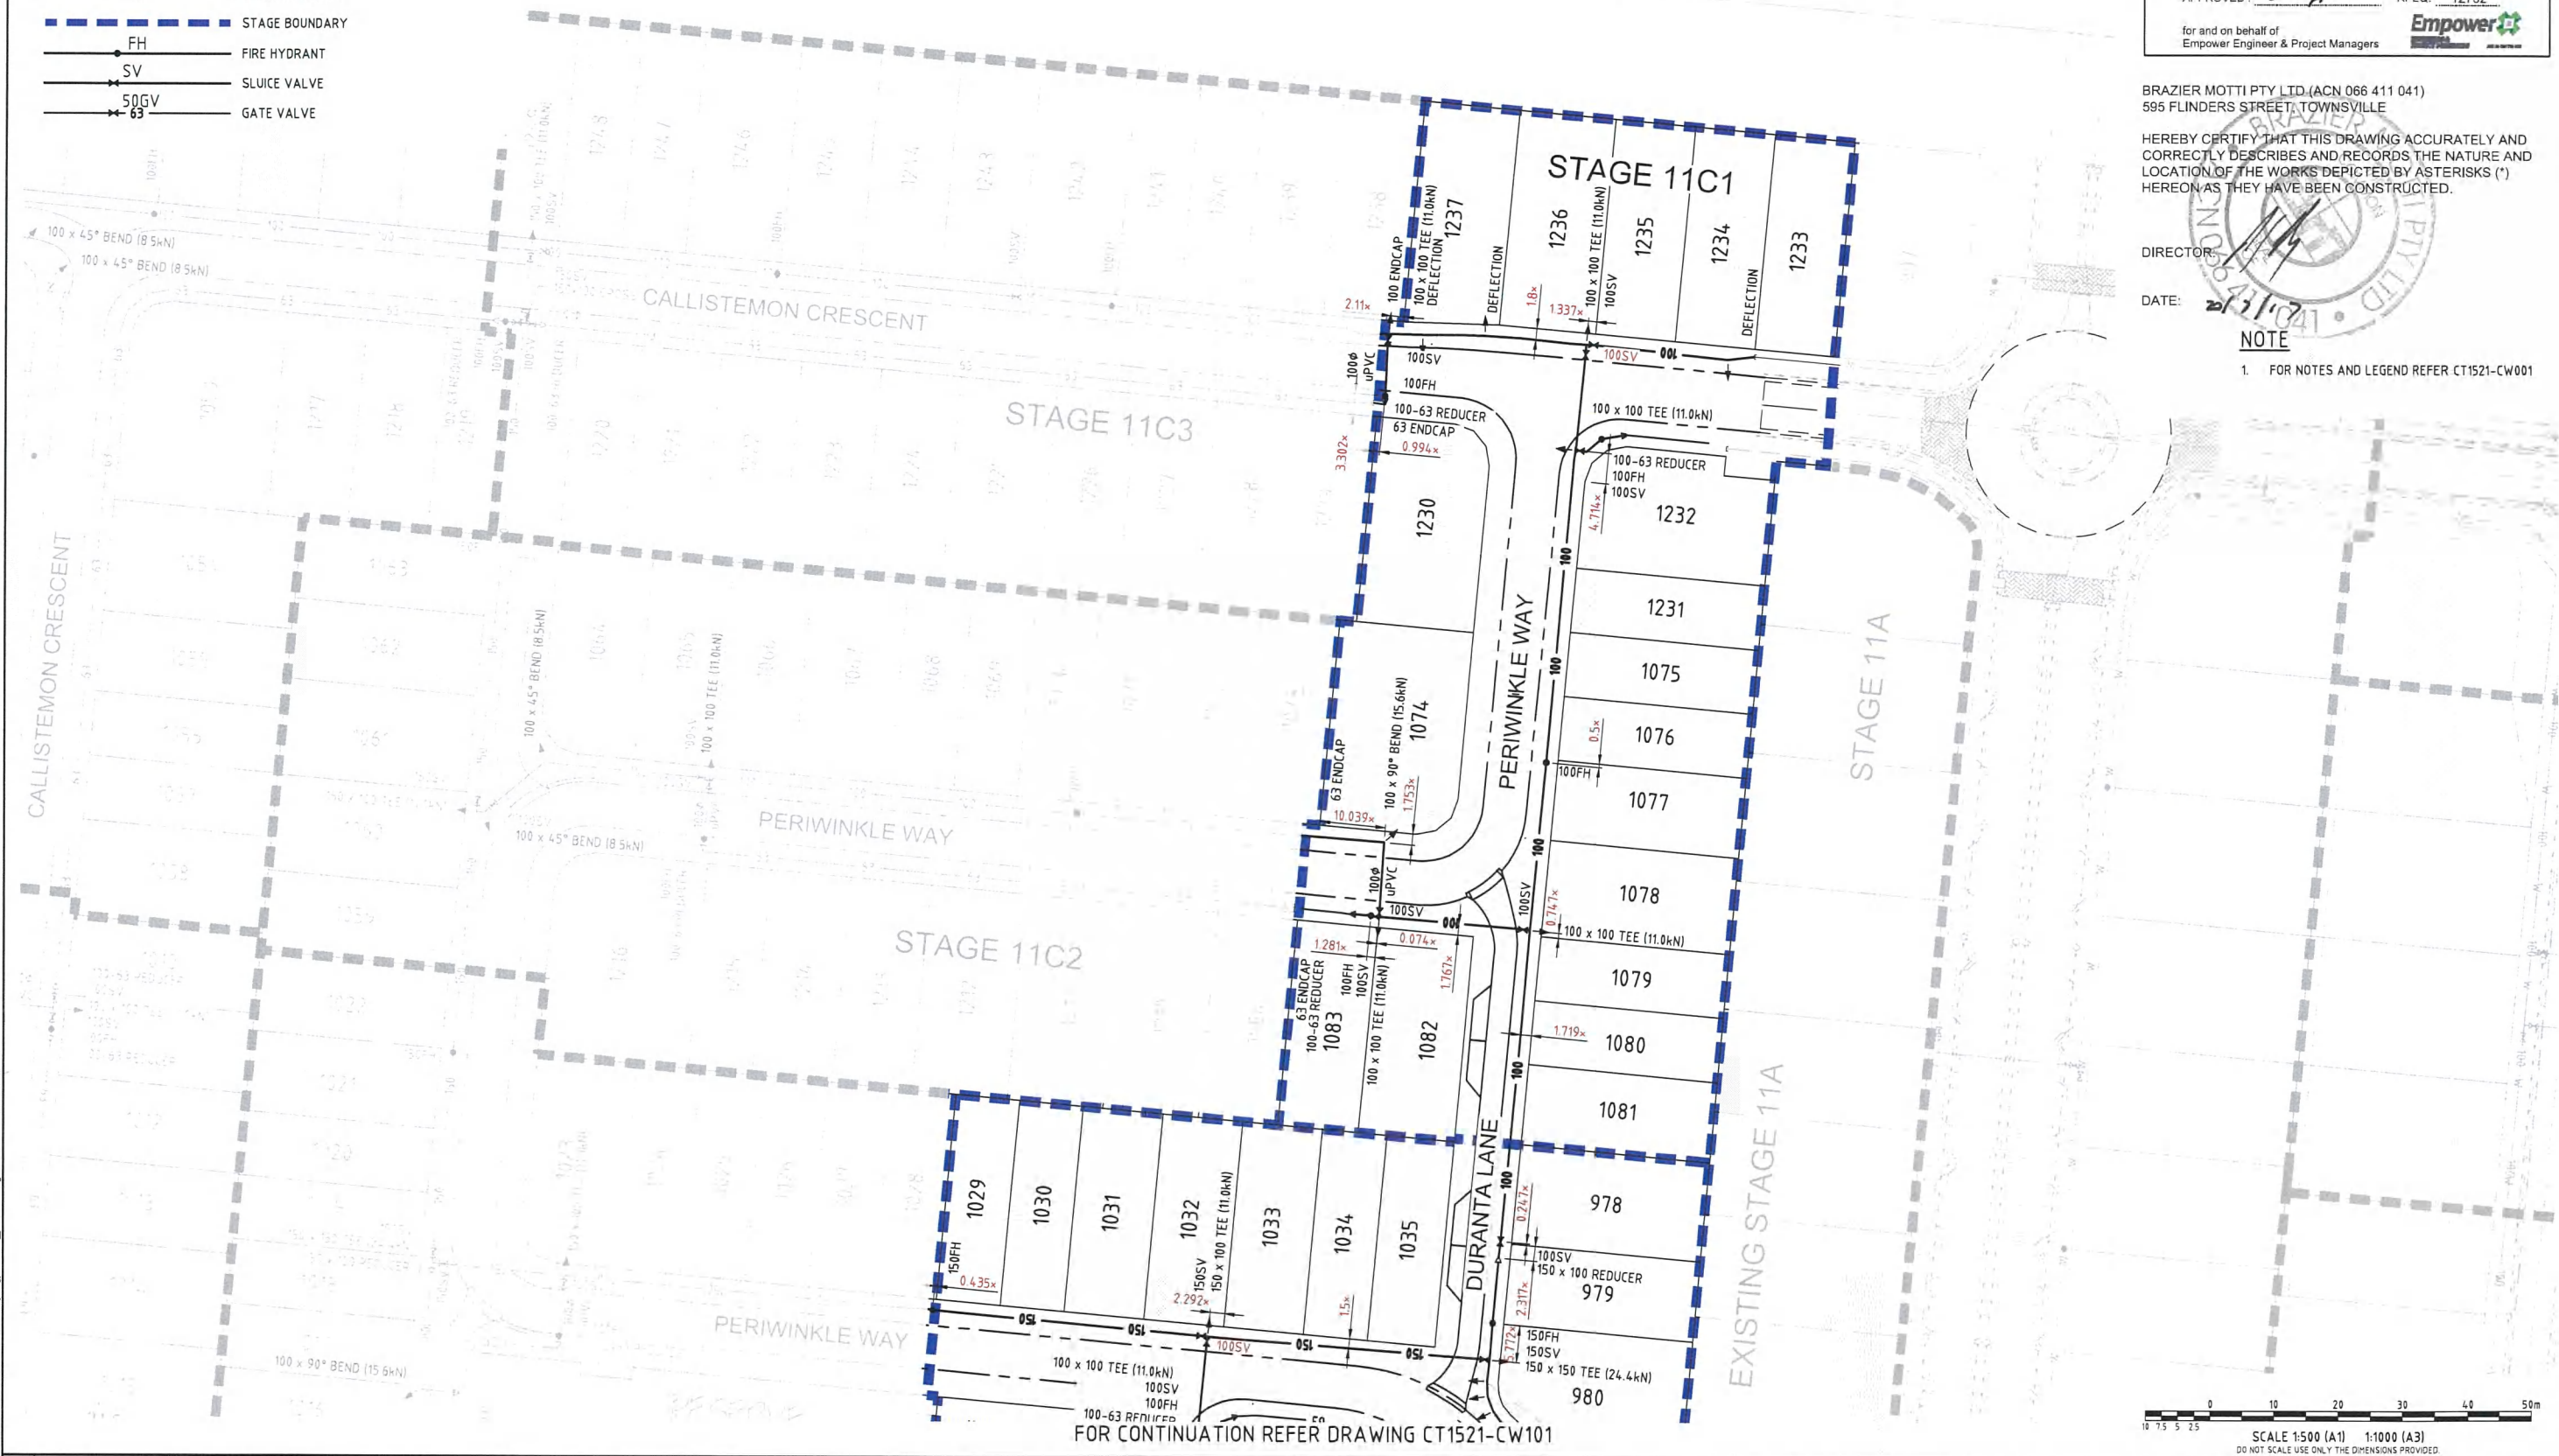


FOR CONTINUATION REFER DRAWING CT1521-CW101


Plot Date: 17/03/2017 2:07:07 PM User: JOSE TURNER File Name: C:\pwworking\1521_2151_urbx.dwg Plot Date: 17/03/2017 2:07:07 PM User: JOSE TURNER File Name: C:\pwworking\1521_2151_urbx.dwg


1	AS CONSTRUCTED	JT	JK	CH	<i>Cheryl Helm</i>	12732	17/03/17
No.	Amendments	Drawn	Design	Appd	Registered Engineer	Reg No.	Date

This drawing cannot be copied or reproduced in any form or used for any purpose other than that originally intended without the written permission of Empower Engineers and Project Managers © COPYRIGHT 2017



Empower
 ENGINEERS & PROJECT MANAGERS
 ABRN 23 010 743 692



Client	URBEX PTY LTD	Datum	AHD	
Project	KALYNDA CHASE STAGE 11B3 AND 11C1	PSM NO.	131651	
Title	WATER RETICULATION LAYOUT (SHEET 2 OF 2)	RL	19.248M	(MGA) COORD
		AS CONSTRUCTED		
		Project No.	CT1521-CW102	Rev
		Drawing No.		1