

FOR CONTINUATION REFER DWG CT-1373-102




**LEGEND**

16.977 FINAL SURFACE LEVEL



BRAZIER MOTTI PTY LTD. ACN 066 411 041  
 595 FLINDERS ST. TOWNSVILLE, HEREBY CERTIFY THAT  
 THIS DRAWING ACCURATELY AND CORRECTLY DESCRIBES  
 AND RECORDS THE NATURE AND LOCATION OF THE WORKS  
 DEPICTED BY ASTERISKS (\*) HEREON AS THEY HAVE BEEN  
 CONSTRUCTED FOR SUBDIVISION.

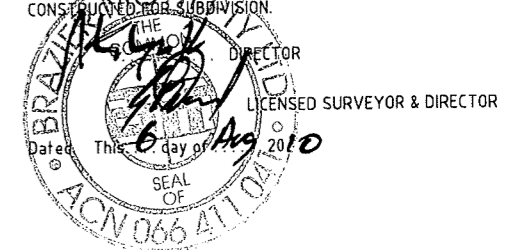


**PROPERTY DESCRIPTION**

LOT 2 ON RP739829

**DATUM**

PM No.131651 LOCATED ON  
 HERVEY RANGE ROAD (BOLT IN BITUMEN)  
 RL 19.248m AHD

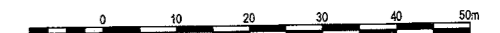

SCALE 1:500 (A1)

DO NOT SCALE, USE ONLY THE DIMENSIONS PROVIDED

User: STRATTON JACOBS@bmd.com.au Date: 06/08/10 10:22 AM

No.	Amendments	By	Appd	Date	No.	Amendments	By	Appd	Date
A	AS CONSTRUCTED	SJJ	[Signature]	06.08.10					


**BMD CONSULTING**  
 Civil Engineers  
 Structural Engineers  
 & Project Managers  
 ABN 23 010 743 692

Townsville Office  
 57 Mitchell Street  
 Townsville  
 P.O. Box 6028  
 Townsville MC, QLD 4810  
 Ph: (07) 4750 7000  
 Fax: (07) 4750 7077  
 email: bmd@bmd.com.au  
 www.bmd.com.au

Head Office - Brisbane  
 Ph: (07) 3893 1511  
 Sydney Office  
 Ph: (02) 9688 5400  
 Cairns Office  
 Ph: (07) 4035 1544


Design	—	Client	<b>URBEX PTY. LTD.</b>	
Drawn	S.J.J.	Project	<b>KALYND CHASE STAGE 8</b>	
Checked	WES	Title	<b>EARTHWORKS LAYOUT PLAN</b>	
Original Approved By:	[Signature]		<b>(SHEET 1 OF 2)</b>	
RPEQ No.	5548		<b>AS CONSTRUCTED</b>	
Date	AUG '10		Drawing No.	CT-1373-101
Datum	A.H.D.		Rev	A

THIS DRAWING CANNOT BE COPIED OR REPRODUCED IN ANY FORM OR USED FOR ANY OTHER PURPOSE OTHER THAN THAT ORIGINALLY INTENDED WITHOUT THE WRITTEN PERMISSION OF BMD CONSULTING PTY LTD.

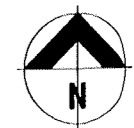


**LEGEND**

16.977 FINAL SURFACE LEVEL

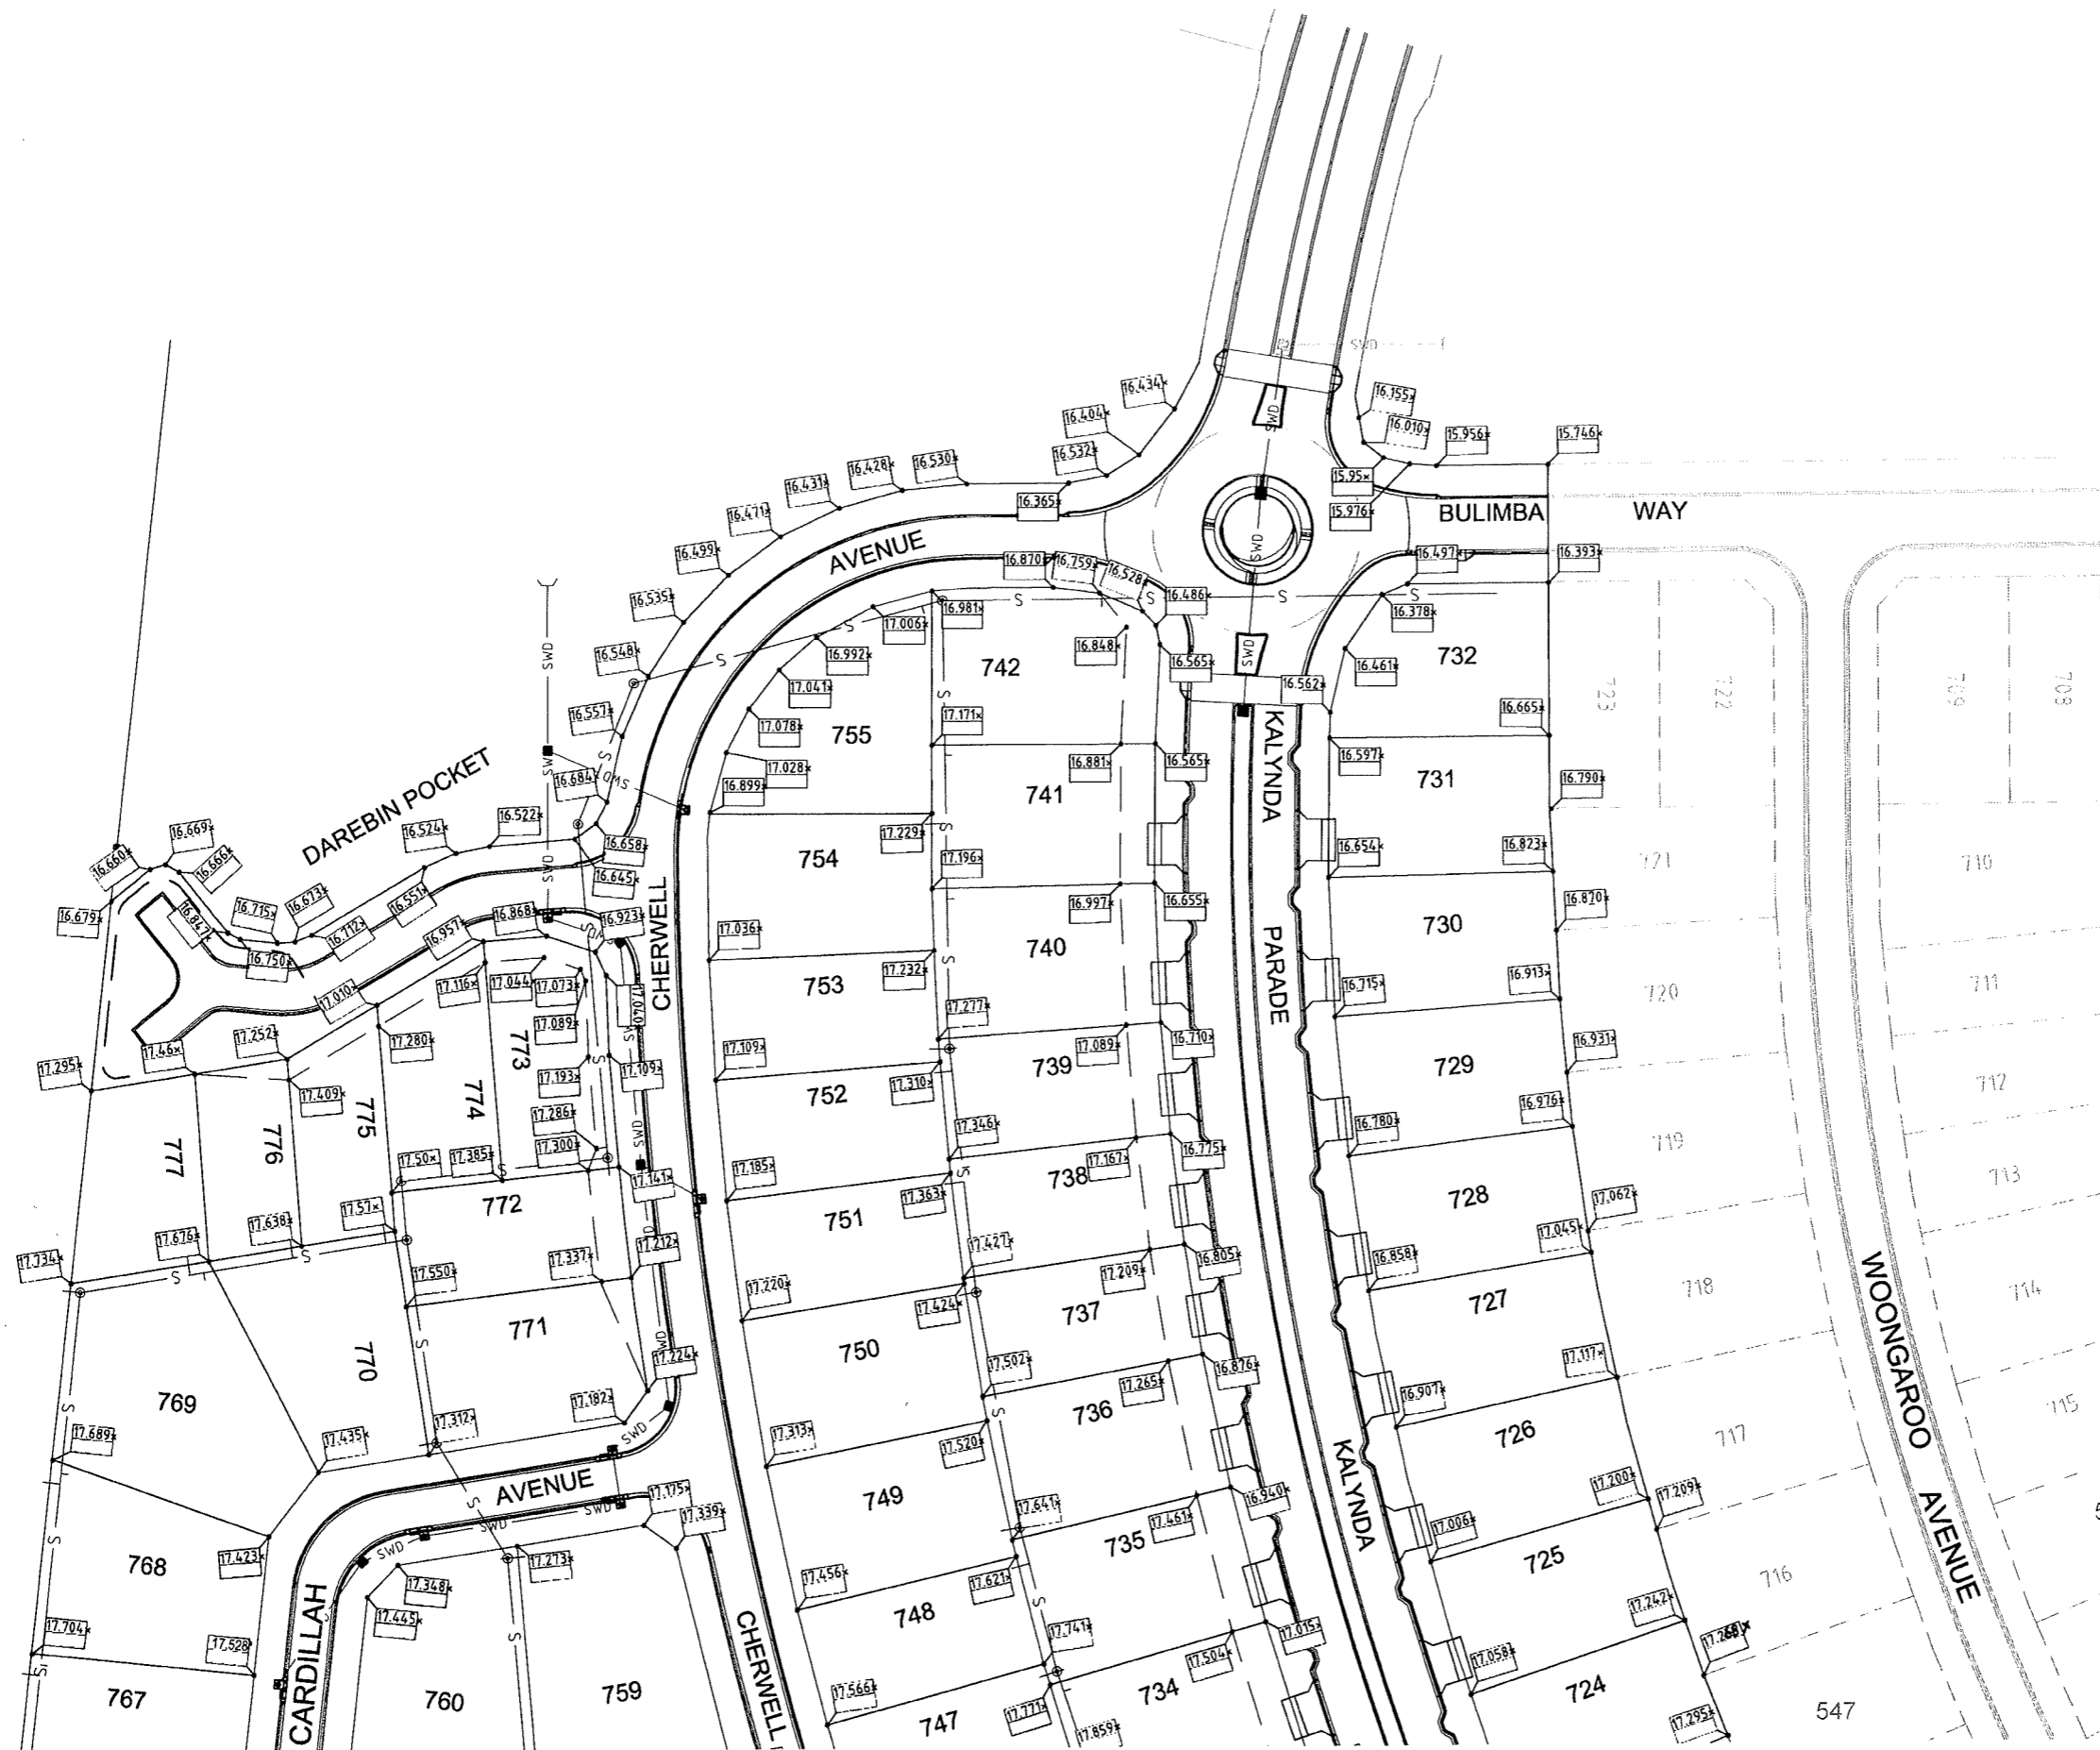


BRAZIER MOTTI PTY LTD. ACN 066 411 041  
 595 FLINDERS ST. TOWNSVILLE. HEREBY CERTIFY THAT  
 THIS DRAWING ACCURATELY AND CORRECTLY DESCRIBES  
 AND RECORDS THE NATURE AND LOCATION OF THE WORKS  
 DEPICTED BY ASTERISKS (\*) HEREON AS THEY HAVE BEEN  
 CONSTRUCTED FOR SUBDIVISION.

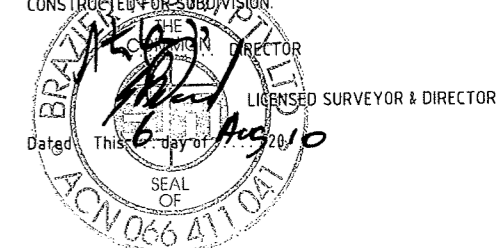

**PROPERTY DESCRIPTION**  
 LOT 2 ON RP738829

**DATUM**  
 PM No. 131851 LOCATED ON  
 HERVEY RANGE ROAD (BOLT IN BITUMEN)  
 RL 19.248m AHD

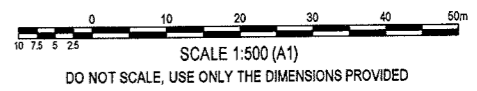

FOR CONTINUATION REFER DWG CT-1373-101

User: STANTON, JACOB; Name: A137-100 - SUBVT-103 - Kalynda Chase - Stage 2 Drawings; Date: 08/10/10; Time: 10:27:28 AM

No.	Amendments	By	Appd	Date	No.	Amendments	By	Appd	Date
A	AS CONSTRUCTED	SJJ	[Signature]	06.08.10					



**BMD CONSULTING**  
 Civil Engineers  
 Structural Engineers  
 & Project Managers  
 ABN 23 010 743 892

Townsville Office: 57 Mitchell Street, Townsville, P.O. Box 6008, Townsville MC, QLD 4810  
 Phone: (07) 4750 7000, Fax: (07) 4750 7077, Email: bmd@bmd.com.au, www.bmd.com.au

Head Office - Brisbane: Ph: (07) 3883 1511  
 Sydney Office: Ph: (02) 9898 5400  
 Cairns Office: Ph: (07) 4035 1544

Design	---
Drawn	S.J.J.
Checked	WES
Original Approved By:	[Signature]
RPEQ No.	6948
Date	AUG '10
Datum	A.H.D.

Client: **URBEX PTY. LTD.**  
 Project: **KALYNDA CHASE STAGE 8**  
 Title: **EARTHWORKS LAYOUT PLAN (SHEET 2 OF 2)**

AS CONSTRUCTED  
 Drawing No. **CT-1373-102**  
 Rev **A**

THIS DRAWING CANNOT BE COPIED OR REPRODUCED IN ANY FORM OR USED FOR ANY OTHER PURPOSE OTHER THAN THAT ORIGINALLY INTENDED WITHOUT THE WRITTEN PERMISSION OF BMD CONSULTING PTY LTD.