
 
 



FOR CONTINUATION REFER DWG. CT-1171-203




LEGEND

-  ALLOTMENT FILL
-  DENOTES BATTER TO EXIST. AT 1 IN 6 SLOPE
-  AS CONSTRUCTED SURFACE LEVEL

BRAZIER MOTY PTY LTD ACN 068 411 041
 595 FUNDERS ST TOWNVILLE HEREBY CERTIFY THAT
 THIS DRAWING ACCURATELY AND CORRECTLY DESCRIBES
 AND REPORTS THE NATURE AND POSITION OF THE WORKS
 DIRECTLY BY ASPECTS THEREON AS THEY HAVE BEEN
 CONDUCTED BY OUR DIVISION.
 DATED 12/07/06
 LICENCED SURVEYOR & DIRECTOR

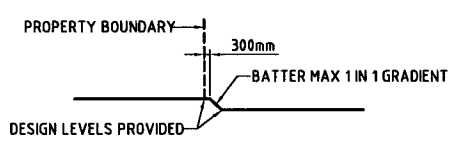


REAR BATTER DETAIL
NOT TO SCALE

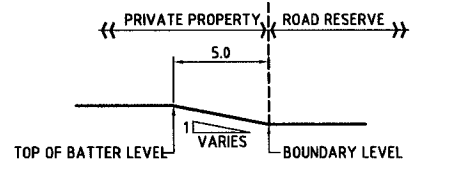


FRONT BATTER DETAIL
NOT TO SCALE

DATUM
 PM No. 131651 LOCATED ON
 HERVEY RANGE ROAD (BOLT IN BITUMEN)
 RL 19.248

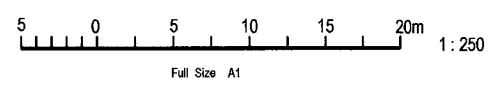

File Name: A:\CT-1171-203\CT-1171-203.dwg User: DE MARTIN Plot Date: 12/27/2006 3:35 PM

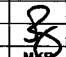No.	Amendments	By	Appd	Date	No.	Amendments	By	Appd	Date
B	EARTHWORK LEVELS AMENDED	JAM		27.07.06					
A	ORIGINAL ISSUE	JAM	MKB	12.07.06					



BMD CONSULTING
 Civil Engineers
 Structural Engineers
 & Project Managers
 APM 23 010 743 692

Townsville Office
 57 Mitchell Street. Ph: (07) 4750 7000
 Townsville Ph: (07) 3893 1511
 P.O. Box 6008 Fax: (07) 4750 7077
 email: bmdcons@bmd.com.au Sydney Office
 Townsville MC, QLD 4810 www.bmd.com.au Ph: (02) 9898 5400 Cairns Office
 Ph: (07) 4035 1544

Design	—
Drawn	JAM
Checked	PAV
Original Approved By:	MKB
RPEQ No.	5555
Date	JULY '06
Datum	A.H.D.

Client: **URBEX PTY LTD**

Project: **KALYNDA CHASE - STAGE 2**

Title: **EARTHWORKS LAYOUT PLAN**
LAYOUT PLAN SHEET 1 OF 6



AS CONSTRUCTED
 Drawing No. **CT-1171-202**
 Rev **B**

THIS DRAWING CANNOT BE COPIED OR REPRODUCED IN ANY FORM OR USED FOR ANY OTHER PURPOSE OTHER THAN THAT ORIGINALLY INTENDED WITHOUT THE WRITTEN PERMISSION OF BMD CONSULTING PTY LTD.




- LEGEND**
- ALLOTMENT FILL
 - DENOTES BATTER TO EXIST. AT 1 IN 6 SLOPE
 - AS CONSTRUCTED SURFACE LEVEL

BRAZIER MOTTI PTY LTD. ACN 066 411 041
 595 FLINDERS ST. TOWNSVILLE, HEREBY CERTIFY THAT THIS DRAWING ACCURATELY AND CORRECTLY DESCRIBES AND RECORDS THE NATURE AND LOCATION OF THE WORKS DEPICTED BY ASTERISKS HEREON AS THEY HAVE BEEN CONSTRUCTED FOR SUBDIVISION

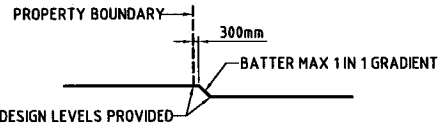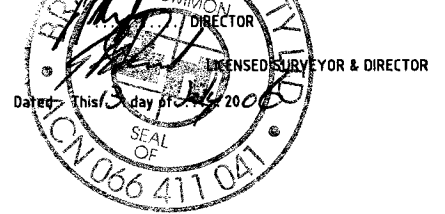


REAR BATTER DETAIL
NOT TO SCALE

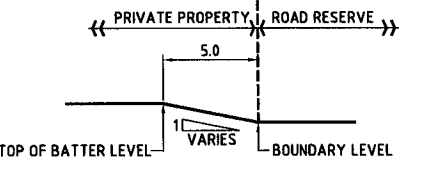

FRONT BATTER DETAIL
NOT TO SCALE

DATUM
 PM No. 131651 LOCATED ON HERVEY RANGE ROAD (BOLT IN BITUMEN) RL 19.248

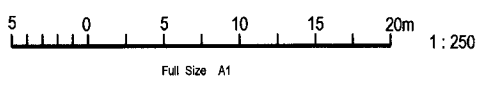

File Name: AUCT-1100 - 2006-CT-1171 - Kalynda Chase Stg 2 Drawings.dwg User: J2E MARTIN
 Plot Date: 2/12/2006 5:09 PM

No.	Amendments	By	Appd	Date	No.	Amendments	By	Appd	Date
A	ORIGINAL ISSUE	JAM		12.07.06					

THIS DRAWING CANNOT BE COPIED OR REPRODUCED IN ANY FORM OR USED FOR ANY OTHER PURPOSE OTHER THAN THAT ORIGINALLY INTENDED WITHOUT THE WRITTEN PERMISSION OF BMD CONSULTING PTY LTD.




 
 
BMD CONSULTING
 Civil Engineers, Structural Engineers & Project Managers
 Townsville Office: 57 Mitchell Street, Ph: (07) 4750 7000, Fax: (07) 4750 7077, P.O. Box 6008, Townsville MC, QLD 4810
 Head Office - Brisbane: Ph: (07) 3893 1511
 Sydney Office: Ph: (02) 9898 5400
 Cairns Office: Ph: (07) 4035 1544

Design	---
Drawn	JAM
Checked	PAV
Original Approved By:	
RPEQ No.	5535
Date	JULY 06
Datum	A.H.D.



Client: **URBEX PTY LTD**
 Project: **KALYNDIA CHASE - STAGE 2**
 Title: **EARTHWORKS LAYOUT PLAN SHEET 2 OF 6**
 AS CONSTRUCTED
 Drawing No. **CT-1171-203** Rev **A**




LEGEND

-  ALLOTMENT FILL
-  DENOTES BATTER TO EXIST. AT 1 IN 6 SLOPE
-  AS CONSTRUCTED SURFACE LEVEL

BRAZIER MOTTI PTY LTD. ACN 066 411 041
 595 FLINDERS ST. TOWNSVILLE. HEREBY CERTIFY THAT THIS DRAWING ACCURATELY AND CORRECTLY DESCRIBES AND RECORDS THE NATURE AND LOCATION OF THE WORKS DEPICTED BY ASTERISKS (*) HEREON AS THEY HAVE BEEN CONSTRUCTED FOR SUBDIVISION.

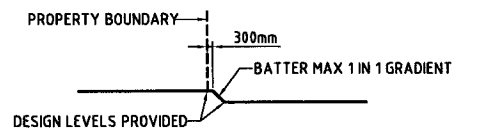
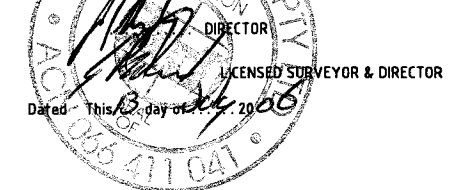


REAR BATTER DETAIL
 NOT TO SCALE

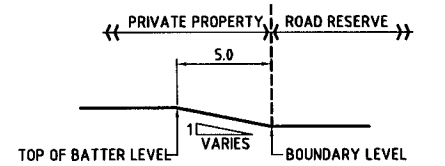

FRONT BATTER DETAIL
 NOT TO SCALE

DATUM
 PH No. 131651 LOCATED ON
 HERVEY RANGE ROAD (BOLT IN BITUMEN)
 RL 19.248

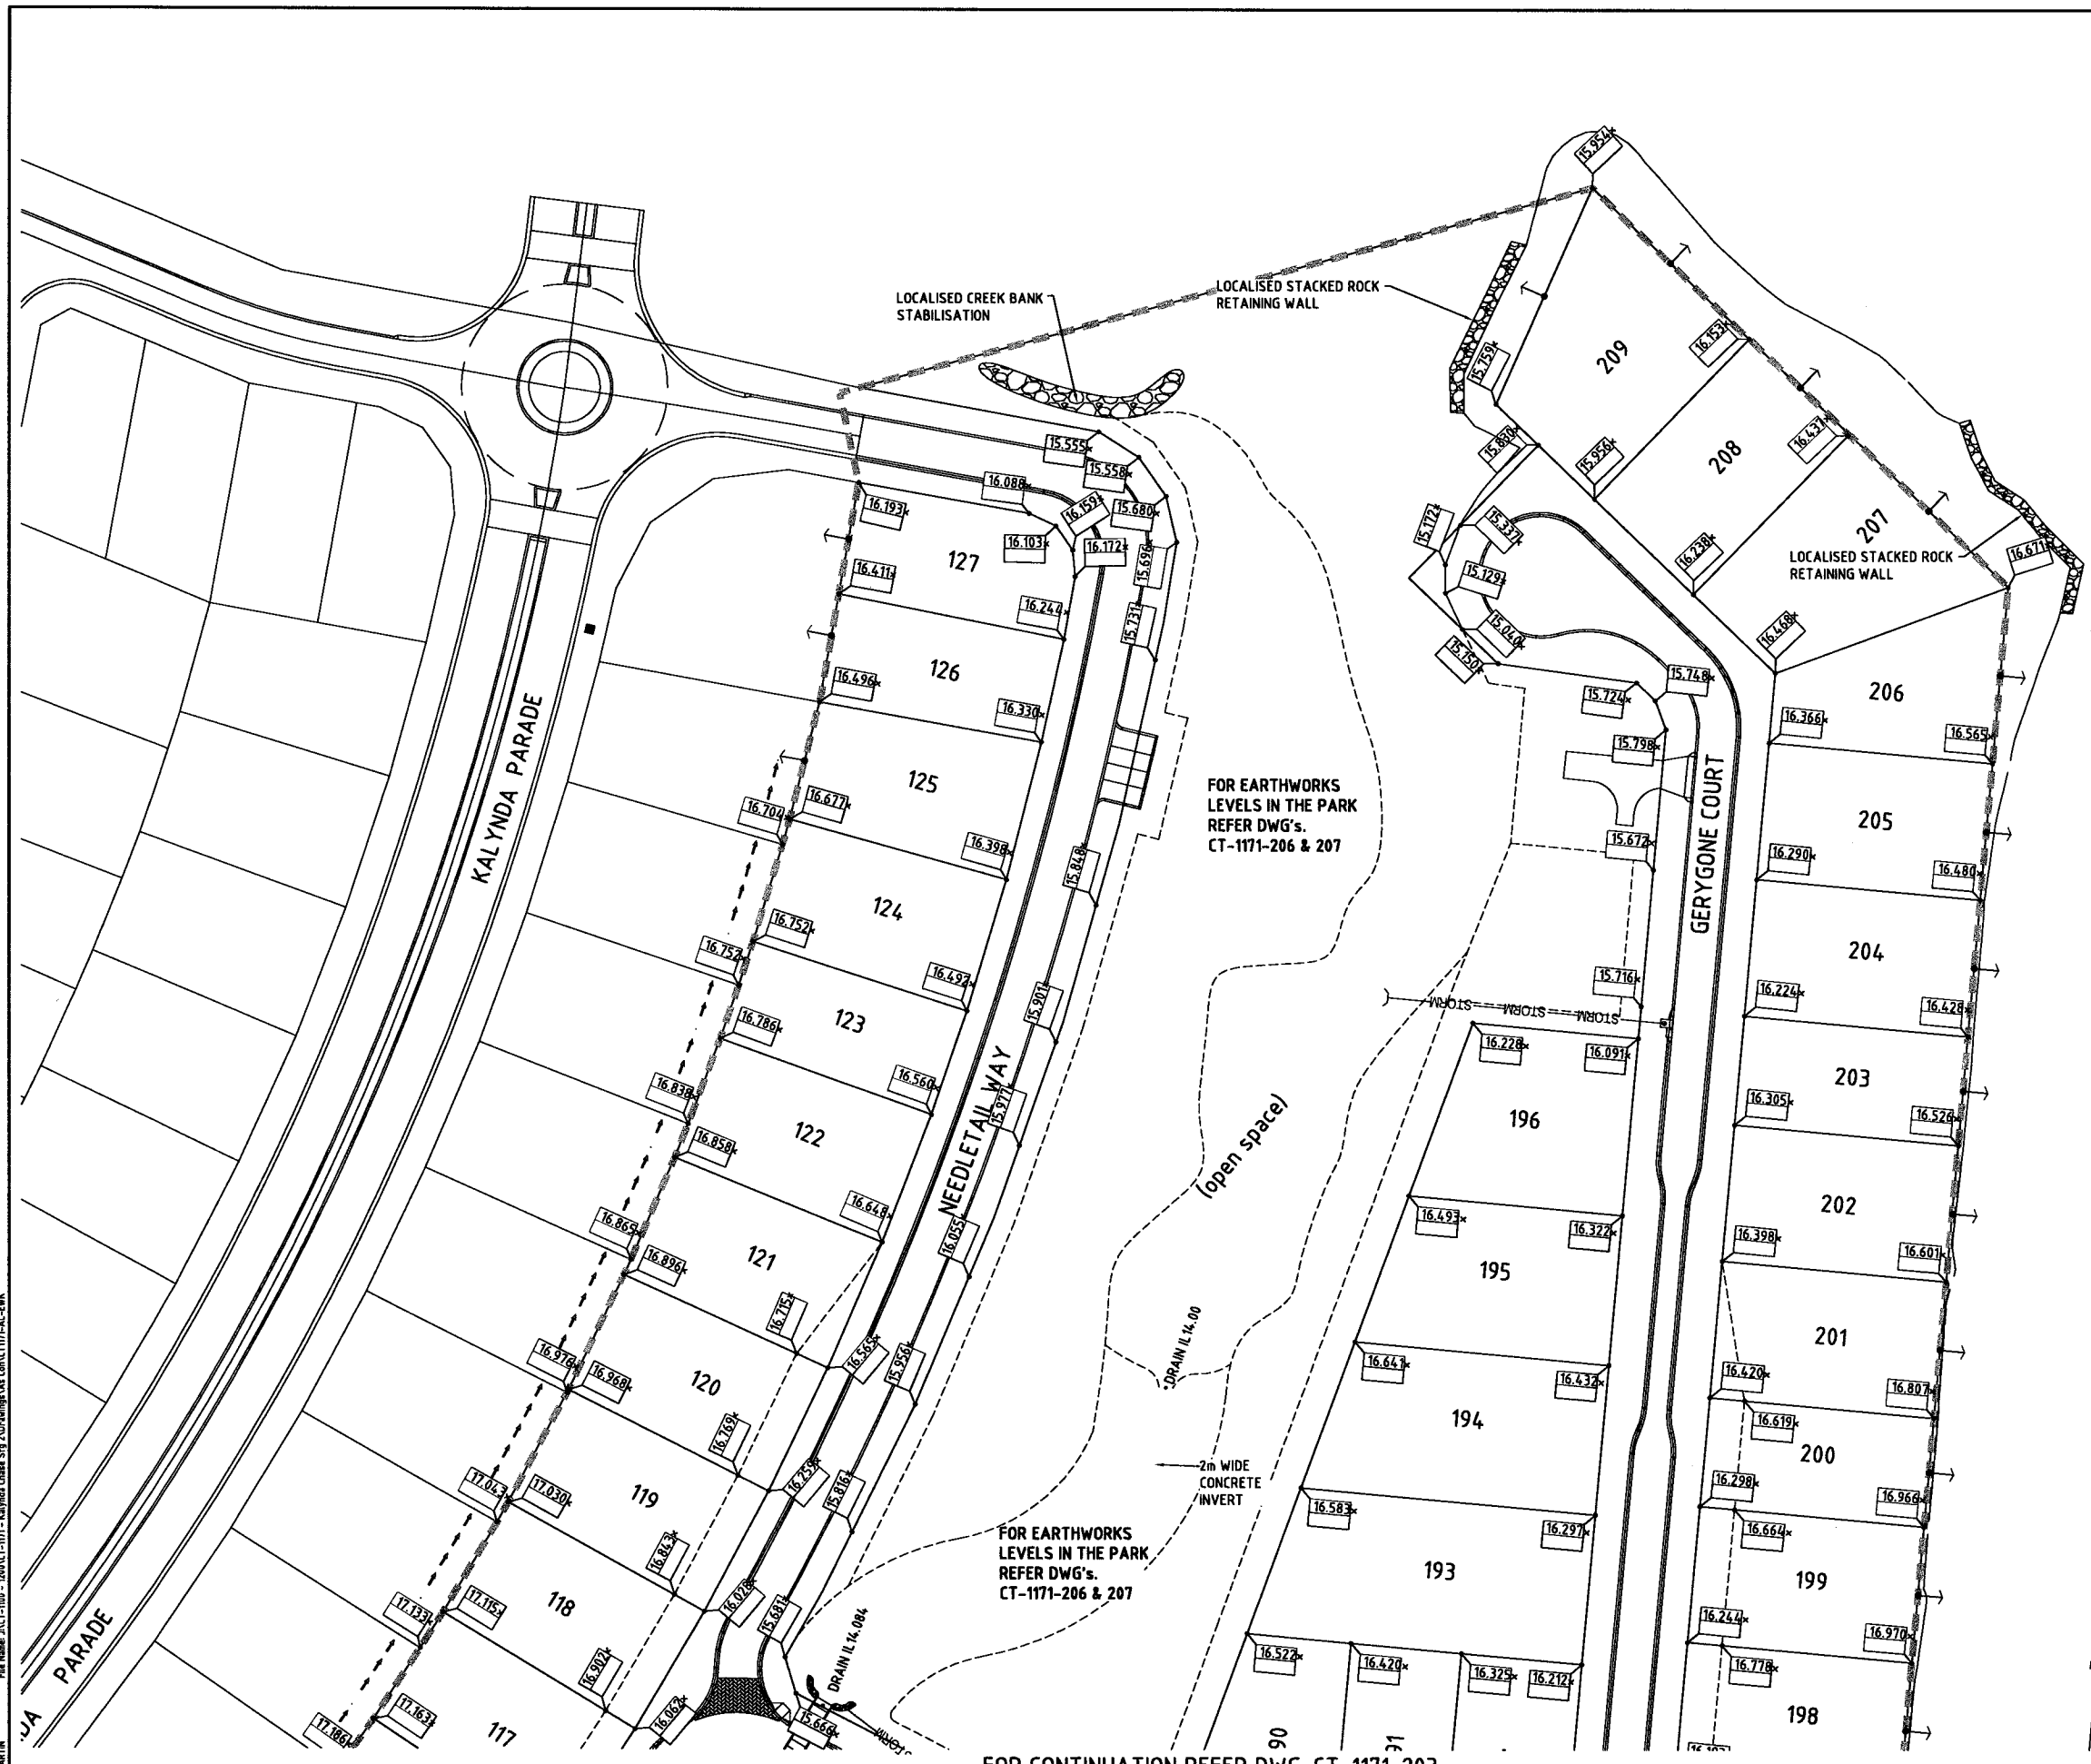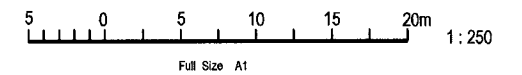

File Name: A:\CT-1171 - 2006\CT-1171 - Kalynda Chase Stg 2\Drawings\A1.ctb
 User: JOE MARTIN
 Plot Date: 7/12/2006 4:55 PM


No.	Amendments	By	Appd	Date	No.	Amendments	By	Appd	Date
A	ORIGINAL ISSUE	JAM		12.07.06					

THIS DRAWING CANNOT BE COPIED OR REPRODUCED IN ANY FORM OR USED FOR ANY OTHER PURPOSE OTHER THAN THAT ORIGINALLY INTENDED WITHOUT THE WRITTEN PERMISSION OF BMD CONSULTING PTY LTD.




BMD CONSULTING
 Civil Engineers
 Structural Engineers
 & Project Managers
 ABN 23 010 743 692

Townsville Office: 57 Mitchell Street, P.O. Box 6008, Townsville MC, QLD 4810
 Phone: (07) 4750 7000, Fax: (07) 4750 7077, Email: bmdcons@mq.bmd.com.au, Website: www.bmd.com.au
 Head Office - Brisbane: Sydney Office, Cairns Office
 Phone: (07) 3893 1511, Phone: (02) 9898 5400, Phone: (07) 4435 1544

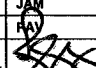Design	—
Drawn	JAM
Checked	RAY
Original Approved By:	
RPEQ No.	—
Date	JULY 06
Datum	A.H.D.

Client: **URBEX PTY LTD**
 Project: **KALYNDIA CHASE - STAGE 2**
 Title: **EARTHWORKS LAYOUT PLAN SHEET 3 OF 6**

AS CONSTRUCTED
 Drawing No. **CT-1171-204** Rev **A**


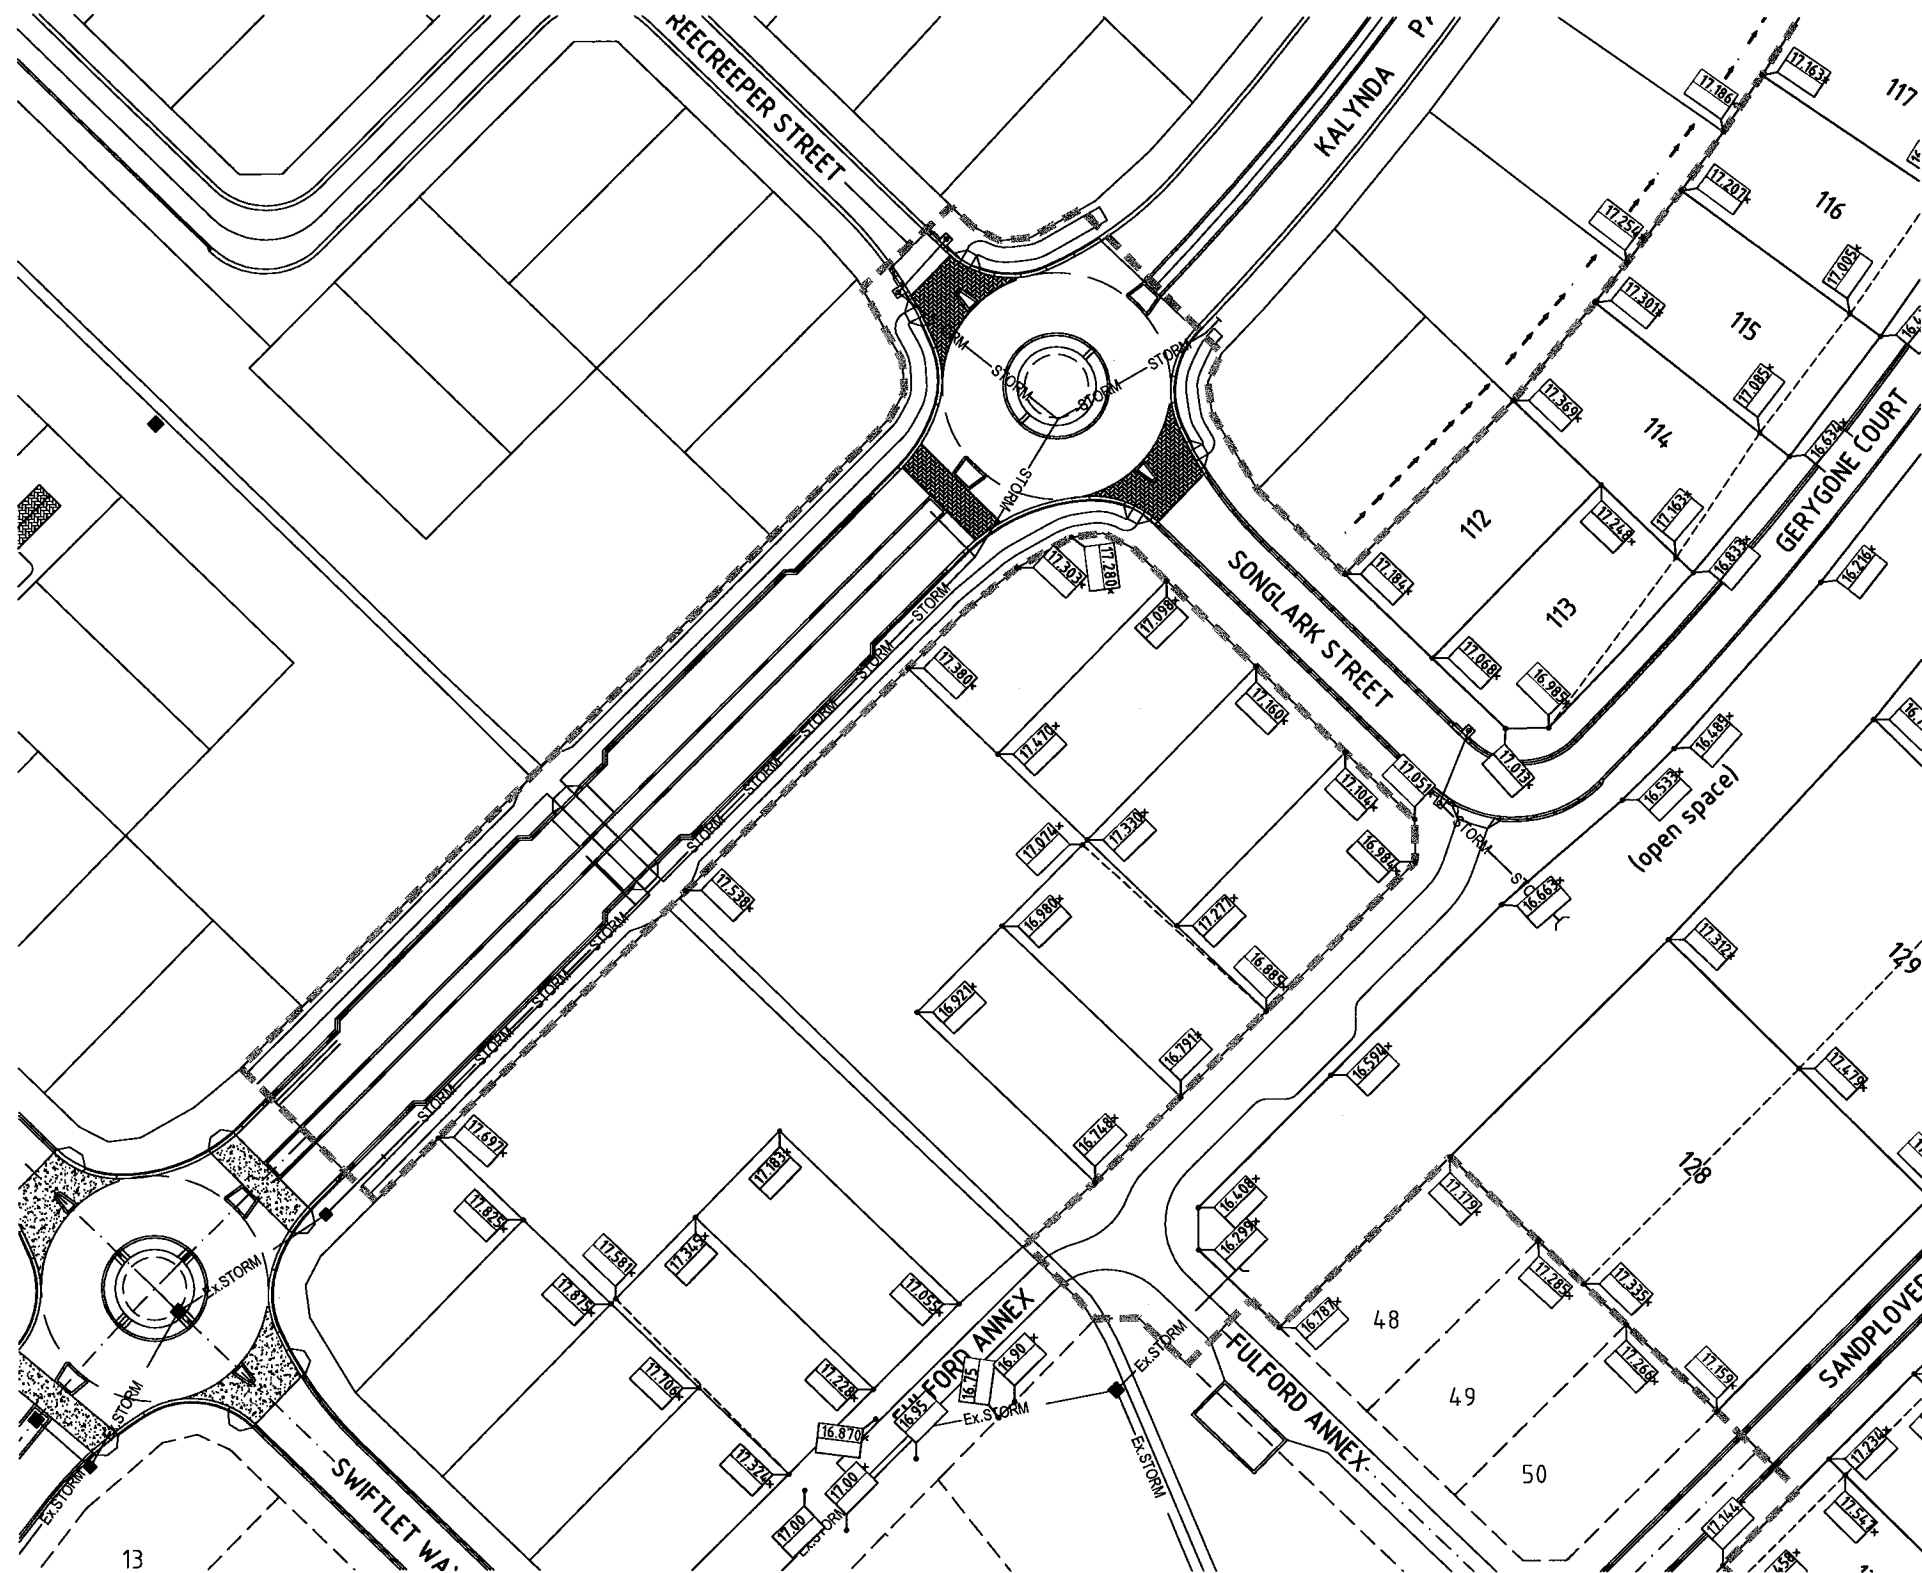


FOR CONTINUATION REFER DWG. CT-1171-203


LEGEND

- ALLOTMENT FILL
- DENOTES BATTER TO EXIST. AT 1 IN 6 SLOPE
- AS CONSTRUCTED SURFACE LEVEL

BRAZIER MOTTI PTY LTD. ACN 066 411 041
 595 FLINDERS ST. TOWNSVILLE, HEREBY CERTIFY THAT THIS DRAWING ACCURATELY AND CORRECTLY DESCRIBES AND RECORDS THE NATURE AND LOCATION OF THE WORKS DEPICTED BY ASTERISKS (*) HEREON AS THEY HAVE BEEN CONSTRUCTED FOR SUBDIVISION

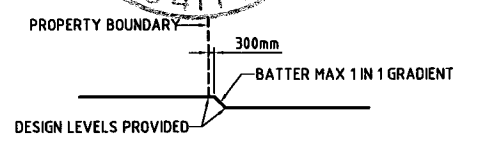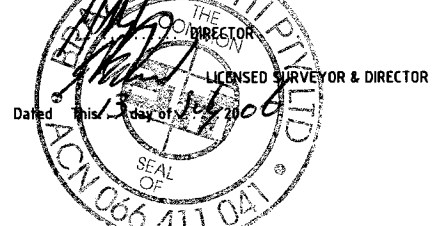


REAR BATTER DETAIL
NOT TO SCALE

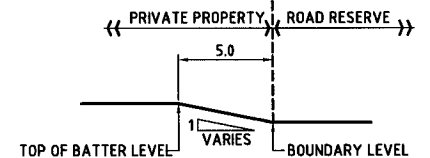

FRONT BATTER DETAIL
NOT TO SCALE

DATUM
 PM No.131651 LOCATED ON HERVEY RANGE ROAD (BOLT IN BITUMEN) RL 19.248

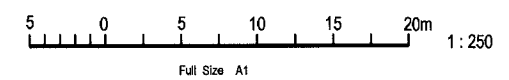

File Name: JACT-110 - 02BACT-111 - Kalymda Chase Stg 2/Earthworks/As Constructed/CT1171-AC-EMK User: DE HARTIN Plot Date: 27/07/2006 03:35 PM

No.	Amendments	By	Appd	Date	No.	Amendments	By	Appd	Date
A	ORIGINAL ISSUE	JAM		12.07.06					



BMD CONSULTING
 Civil Engineers, Structural Engineers & Project Managers
 Townsville Office: 57 Mitchell Street, P.O. Box 6008, Townsville MC, QLD 4810
 Brisbane Office: 57 Mitchell Street, P.O. Box 6008, Townsville MC, QLD 4810
 Sydney Office: P.O. Box 6008, Townsville MC, QLD 4810
 Cairns Office: P.O. Box 6008, Townsville MC, QLD 4810

Design	JAM
Drawn	JAM
Checked	PTM
Original Approved By:	<i>[Signature]</i>
RPEQ No.	5555
Date	JULY '06
Datum	A.H.D.

URBEX PTY LTD
KALYMDA CHASE - STAGE 2
EARTHWORKS LAYOUT PLAN
SHEET 4 OF 6
AS CONSTRUCTED
 Drawing No. CT-1171-205 Rev A