



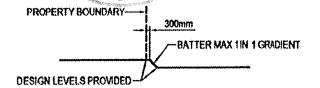


LEGEND


- -> DENOTES BATTER TO EXIST. AT 1 IN 8 SLOPE
- 11.55 AS CONSTRUCTED SURFACE LEVEL

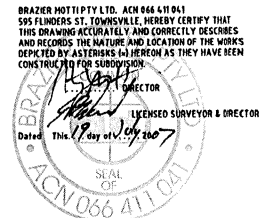

REAR BATTER DETAIL
NOT TO SCALE

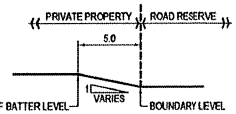

DATUM
 PM No. 13 1851 LOCATED ON
 HERVEY RANGE ROAD (BOLT IN BITUMEN)
 RL 19.248

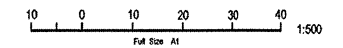

No.	Amendments	By	Appd	Date	No.	Amendments	By	Appd	Date
A	ORIGINAL ISSUE			18.07.07					

URBEX
 Civil Engineers
 Structural Engineers
 Project Managers
 ABN 55 010 745 692

Townsville Office
 87 Likiep Street
 Townsville QLD 4810
 Ph: (07) 4750 7000
 Fax: (07) 4750 7077
 Email: info@urbex.com.au
 Townsville MC QLD 4810

BMD
 CONSULTING

Head Office Brisbane
 Ph: (07) 3463 1511
 Email: info@bmd.com.au
 Ph: (05) 9008 5000

Design: S.J.J.
 Drawn: W.E.S.
 Checked: W.E.S.
 Original Approved By: [Signature]
 Date: 15 JUL 07
 Datum: A.H.D.

Client: **URBEX Pty Ltd**
 Project: **KALYNDA CHASE - STAGE 4 B**
 Title: **EARTHWORKS LAYOUT PLAN**

AS CONSTRUCTED
 Drawing No. **CT-1173-402**
 Rev **A**

THIS DRAWING CANNOT BE COPIED OR REPRODUCED IN ANY FORM OR USED FOR ANY OTHER PURPOSE OTHER THAN THAT ORIGINALLY INTENDED WITHOUT THE WRITTEN PERMISSION OF BMD CONSULTING PTY LTD.