


LEGEND




→ DENOTES BATTER TO EXIST. AT 1 IN 6 SLOPE

16.38 FINAL SURFACE LEVEL WITH REQUIRED CUT OR FILL (-0.89) CUT VALUE OR (0.32) FILL VALUE. WHERE 'NAT' IS RECORDED AGAINST THE LEVEL AND THE ACTUAL LEVEL IN SITU VARIES FROM THE SURFACE LEVEL INDICATED ON THE DRAWINGS THE IN SITU LEVEL SHALL TAKE PRECEDENCE.

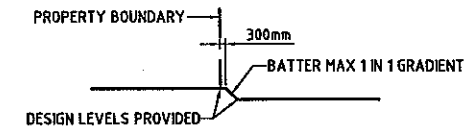

REAR BATTER DETAIL
NOT TO SCALE

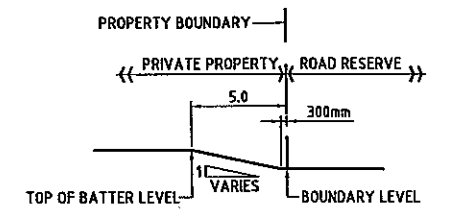


FRONT BATTER DETAIL
NOT TO SCALE



NOTES

- DESIGN LEVELS SHOWN INSIDE OF PARKS AND AT BOTTOM OF BATTERS IN PARKS WERE LOWERED BY 100mm FOR BULK EARTHWORKS TO ALLOW FOR TOPSOIL AND TURF BY LANDSCAPING CONTRACTOR
- ALL WORKS IN PARK WERE PEGGED AND VERIFIED BY SUPERINTENDENT PRIOR TO COMMENCING WORKS
- ALL PARK BATTER TREATMENTS ADJACENT EXISTING GULLY ARE FINISHED WITH A SLOPE OF 1 ON 3. FINAL BATTER TREATMENTS AS PER LANDSCAPE ARCHITECTS DETAIL.

BRAZIER MOTTIPTY LTD. ACN 066 411 041
595 FLINDERS ST. TOWNSVILLE, HEREBY CERTIFY THAT THIS DRAWING ACCURATELY AND CORRECTLY DESCRIBES AND RECORDS THE NATURE AND LOCATION OF THE WORKS DEPICTED BY ASTERISKS HEREON AS THEY HAVE BEEN CONSTRUCTED FOR SUBDIVISION.

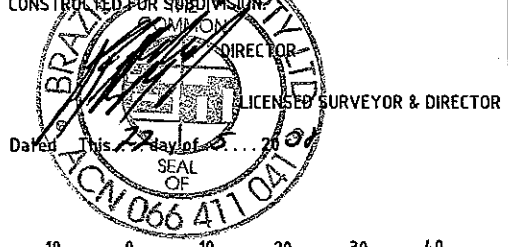

DATUM
PM No.131651 LOCATED ON
HERVEY RANGE ROAD (BOLT IN BITUMEN)
RL 19.248m AHD

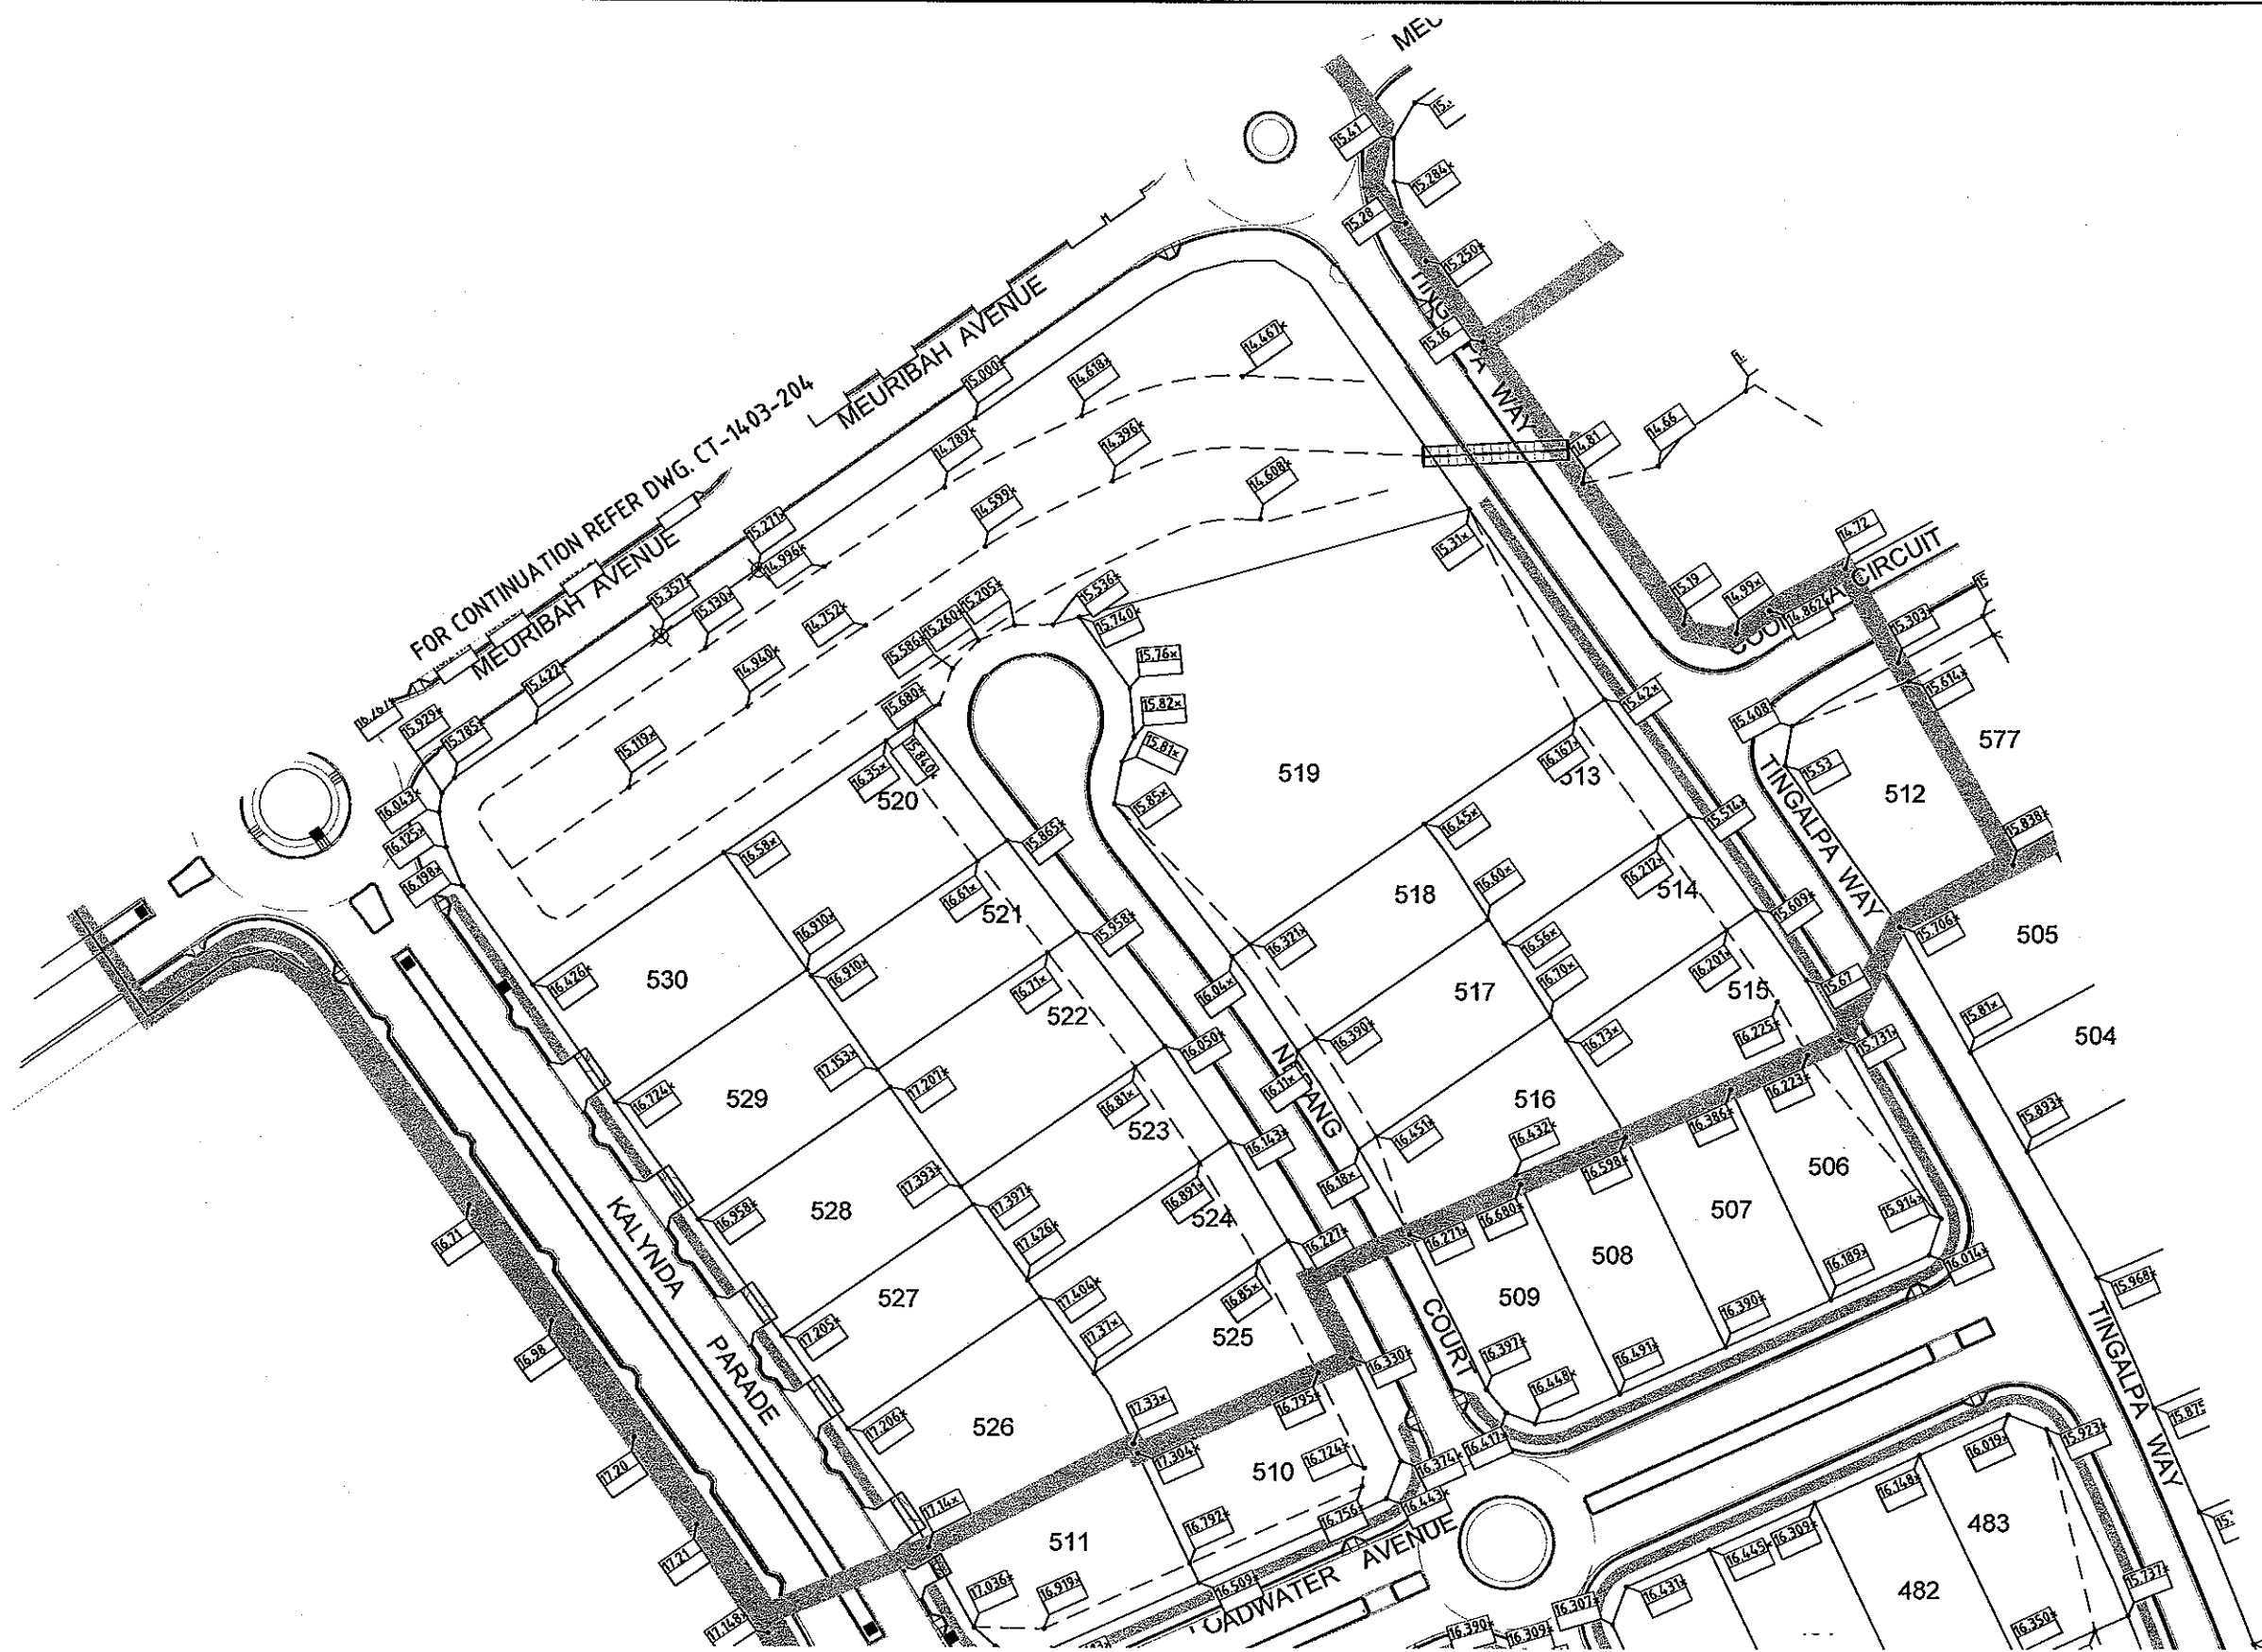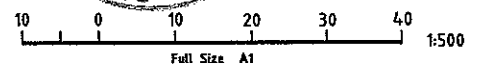

FOR CONTINUATION REFER DWG. CT-1403-204

User: ALEOS MORELLI File Name: JACT-569 - 5810CT-1403 - Kalynnda Chase Stage 5B.dwg Plot No: 1403 ABP Plot Date: 27/05/2008 10:30:47 AM

No.	Amendments	By	Appd	Date	No.	Amendments	By	Appd	Date
A	ORIGINAL ISSUE	AM		21.05.08					

THIS DRAWING CANNOT BE COPIED OR REPRODUCED IN ANY FORM OR USED FOR ANY OTHER PURPOSE OTHER THAN THAT ORIGINALLY INTENDED WITHOUT THE WRITTEN PERMISSION OF BMD CONSULTING PTY LTD.



BMD CONSULTING
Civil Engineers
Structural Engineers
& Project Managers
ABN 29 010 743 682

Townsville Office: 57 Mitchell Street, Townsville, P.O. Box 6008, Townsville, QLD 4810
Ph: (07) 4750 7200, Fax: (07) 4750 7227, email: bmd@bmdconsulting.com.au, www.bmd.com.au

Head Office - Brisbane: Ph: (07) 3833 1511
Sydney Office: Ph: (02) 9898 5400
Cairns Office: Ph: (07) 4035 7544


Design	AM
Drawn	AM
Checked	JL
Original Approved By:	<i>[Signature]</i>
RPEQ No.	1848
Date	MAY 2008

Client
URBEX PTY LTD

Project
KALYNDIA STAGE 5B


Title
EARTHWORKS LAYOUT PLAN
SHEET 1 OF 2

AS CONSTRUCTED
Drawing No. CT-1403-203 Rev. A

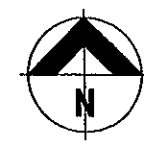


LEGEND

- DENOTES BATTER TO EXIST. AT 1 IN 6 SLOPE
- 16.38 FINAL SURFACE LEVEL WITH REQUIRED CUT OR FILL (-0.89) CUT VALUE OR (0.32) FILL VALUE. WHERE 'NAT' IS RECORDED AGAINST THE LEVEL AND THE ACTUAL LEVEL IN SITU VARIES FROM THE SURFACE LEVEL INDICATED ON THE DRAWINGS THE IN SITU LEVEL SHALL TAKE PRECEDENCE.

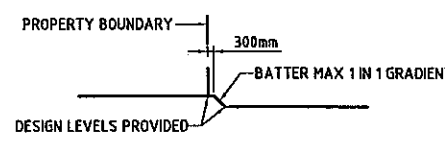

REAR BATTER DETAIL
NOT TO SCALE

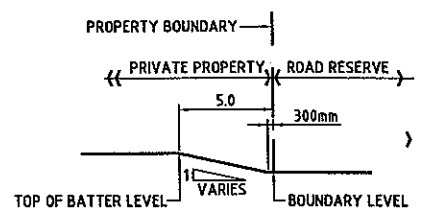


FRONT BATTER DETAIL
NOT TO SCALE


NOTES

1. DESIGN LEVELS SHOWN INSIDE OF PARKS AND AT BOTTOM OF BATTERS IN PARKS ARE TO BE LOWERED BY 100mm FOR BULK EARTHWORKS TO ALLOW FOR TOPSOIL AND TURF BY LANDSCAPING CONTRACTOR
2. ALL WORKS IN PARK TO BE PEGGED AND VERIFIED BY SUPERINTENDENT PRIOR TO COMMENCING WORKS
3. ALL PARK BATTER TREATMENTS ADJACENT EXISTING GULLY TO BE FINISHED WITH A SLOPE OF 1 ON 3. FINAL BATTER TREATMENTS AS PER LANDSCAPE ARCHITECTS DETAIL.

BRAZIER MOTTI PTY LTD. ACN 066 411 041
595 FLINDERS ST. TOWNSVILLE, HEREBY CERTIFY THAT THIS DRAWING ACCURATELY AND CORRECTLY DESCRIBES AND RECORDS THE NATURE AND LOCATION OF THE WORKS DEPICTED BY ASTERISKS THEREON AS THEY HAVE BEEN CONSTRUCTED FOR SUBDIVISION

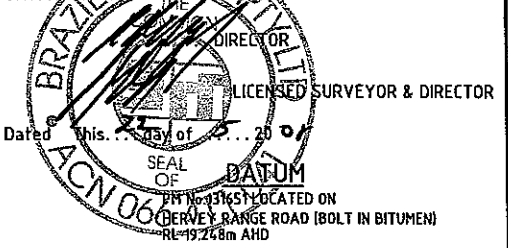


FOR CONTINUATION REFER DWG. CT-1403-203

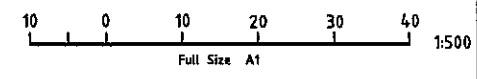

User: ALEDSE MORELLI File Name: JCT-1403 - 595 Flinders St Stage 5A & 5B Stage 5B UrbanPlan CT-1403 ABP Plot Date: 27/05/2008 10:52:21 AM

No.	Amendments	By	Appd	Date	No.	Amendments	By	Appd	Date
A	ORIGINAL ISSUE	AM		21.05.08					

THIS DRAWING CANNOT BE COPIED OR REPRODUCED IN ANY FORM OR USED FOR ANY OTHER PURPOSE OTHER THAN THAT ORIGINALLY INTENDED WITHOUT THE WRITTEN PERMISSION OF BMD CONSULTING PTY LTD.

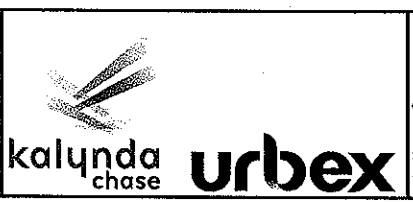

BMD CONSULTING
Civil Engineers
Structural Engineers
& Project Managers
AS/NZS 23 010 743 802

Townsville Office: 57 Mitchell Street, Townsville, P.O. Box 6608, Townsville NC, QLD 4810
Ph: (07) 4750 7000, Fax: (07) 4750 7077, email: bmdcons@bmdcons.com.au, www.bmd.com.au

Head Office - Brisbane: Ph: (07) 3893 1511
Sydney Office: Ph: (02) 9898 5400
Cairns Office: Ph: (07) 4335 1544

Design	AM
Drawn	AM
Checked	JL
Original Approved By:	<i>[Signature]</i>
RPEQ No.	5948
Date	MAY 2008

Client: **URBEX PTY LTD**
Project: **KALYNDA STAGE 5B**
Title: **EARTHWORKS LAYOUT PLAN SHEET 2 OF 2**

AS CONSTRUCTED
Drawing No. **CT-1403-204** Rev **A**