
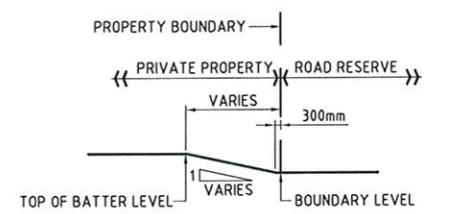


- LEGEND**
- DENOTES BATTER TO EXIST. AT 1 IN 6 SLOPE
 - 16.38
0.11 FINAL SURFACE LEVEL WITH REQUIRED CUT OR FILL (-0.89) CUT VALUE OR (0.32) FILL VALUE. WHERE 'NAT' IS RECORDED AGAINST THE LEVEL AND THE ACTUAL LEVEL IN SITU VARIES FROM THE SURFACE LEVEL INDICATED ON THE DRAWINGS THE IN SITU LEVEL SHALL TAKE PRECEDENCE.
 - SOLE DESIGNATED DRIVEWAY LOCATION FOR EACH LOT (CONSTRUCTED BY OTHERS).
 - x AS CONSTRUCTED DATA

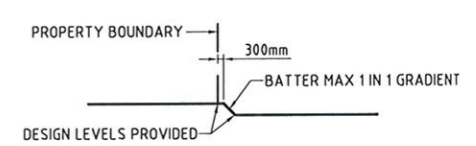


- NOTES**
1. DESIGN LEVELS SHOWN INSIDE OF PARKS AND AT BOTTOM OF BATTERS IN PARKS ARE LOWERED BY 100mm FOR BULK EARTHWORKS TO ALLOW FOR TOPSOIL AND TURF BY LANDSCAPING CONTRACTOR
 2. ALL WORKS IN PARK PEGGED AND VERIFIED BY SUPERINTENDENT PRIOR TO COMMENCING WORKS
 3. ALL PARK BATTER TREATMENTS ADJACENT EXISTING GULLY WERE FINISHED WITH A SLOPE OF 1 ON 3. FINAL BATTER TREATMENTS AS PER LANDSCAPE ARCHITECTS DETAIL.

DATUM
PM No.131651 LOCATED ON HERVEY RANGE ROAD (BOLT IN BITUMEN) RL 19.248m AHD

BRAZIER MOTTI PTY LTD. ACN 066 411 041
595 FLINDERS ST. TOWNSVILLE, HEREBY CERTIFY THAT THIS DRAWING ACCURATELY AND CORRECTLY DESCRIBES AND RECORDS THE NATURE AND LOCATION OF THE WORKS DEPICTED BY ASTERISKS (*) HEREON AS THEY HAVE BEEN CONSTRUCTED FOR SUBDIVISION.

[Signature]
DIRECTOR
LICENSED SURVEYOR & DIRECTOR

Dated this 12 day of 11, 2009

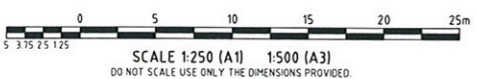

User: STATION JACOBS Name: JCT-559 - 800VCT-559 - Kalynnda Stage 5D L1 CIVL_DWG_S14 - AS CON - EWK
Plot Date: 11/12/2009 12:30:19 PM

No.	Amendments	Drawn	Design	Appd	Certified	Reg No.	Date
A	ORIGINAL ISSUE	S.J.J.	E.J.C.			5948	09.11.09

1st Floor,
57 Mitchell Street North Ward QLD 4810
PO Box 6008 Townsville MC QLD 4810
P: 07 4750 7000 F: 07 4750 7077
E: townsville@bmd.com.au
www.bmd.com.au
ABN 23 010 743 692

Client	URBEX PTY LTD	Datum	AHD
Project	KALYNDA STAGE 5D	RL	19.248
Title	EARTHWORKS LAYOUT PLAN	(AMG) COORD	
		AS CONSTRUCTED	
Project No.	CT-1569-CE101	Drawing No.	
Rev			A

This drawing cannot be copied or reproduced in any form or used for any purpose other than that originally intended without the written permission of BMD Consulting Pty Ltd. © COPYRIGHT 2009