



**LEGEND**

- DENOTES BATTER TO EXIST. AT 1 IN 6 SLOPE
- 16.38 FINAL SURFACE LEVEL WITH REQUIRED CUT OR FILL (-0.89) CUT VALUE OR (0.32) FILL VALUE. WHERE 'NAT' IS RECORDED AGAINST THE LEVEL AND THE ACTUAL LEVEL IN SITU VARIES FROM THE SURFACE LEVEL INDICATED ON THE DRAWINGS THE IN SITU LEVEL SHALL TAKE PRECEDENCE.

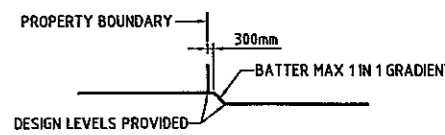

**REAR BATTER DETAIL**  
NOT TO SCALE

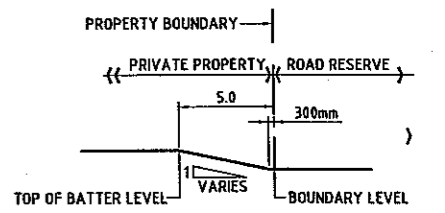



**FRONT BATTER DETAIL**  
NOT TO SCALE

**NOTES**

- DESIGN LEVELS SHOWN INSIDE OF PARKS AND AT BOTTOM OF BATTERS IN PARKS ARE TO BE LOWERED BY 100mm FOR BULK EARTHWORKS TO ALLOW FOR TOPSOIL AND TURF BY LANDSCAPING CONTRACTOR
- ALL WORKS IN PARK TO BE PEGGED AND VERIFIED BY SUPERINTENDENT PRIOR TO COMMENCING WORKS
- ALL PARK BATTER TREATMENTS ADJACENT EXISTING GULLY TO BE FINISHED WITH A SLOPE OF 1 ON 3. FINAL BATTER TREATMENTS AS PER LANDSCAPE ARCHITECTS DETAIL.

FOR CONTINUATION REFER DWG. CT1403-301

BRAZIER MOTTI PTY LTD. ACN 066 411 041  
595 FLINDERS ST. TOWNSVILLE, HEREBY CERTIFY THAT THIS DRAWING ACCURATELY AND CORRECTLY DESCRIBES AND RECORDS THE NATURE AND LOCATION OF THE WORKS DEPICTED BY ASTERISKS (\*) HEREON AS THEY HAVE BEEN CONSTRUCTED FOR SUBDIVISION

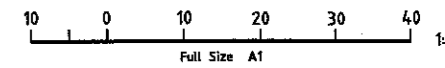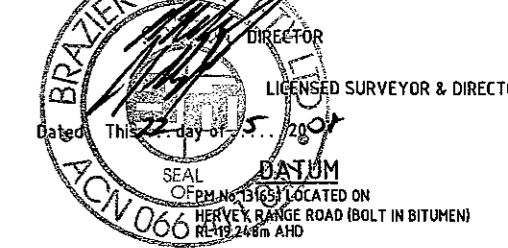

User: ALEXIS MORELLI File Name: JCT-1403 - 8051CT-1403 - Kalynda Chase Stage 5A & 5B Stage 5B Drawings/CT-1403 A8P

No.	Amendments	By	Appd	Date	No.	Amendments	By	Appd	Date
A	ORIGINAL ISSUE	AM		20.05.08					

THIS DRAWING CANNOT BE COPIED OR REPRODUCED IN ANY FORM OR USED FOR ANY OTHER PURPOSE OTHER THAN THAT ORIGINALLY INTENDED WITHOUT THE WRITTEN PERMISSION OF BMD CONSULTING PTY LTD.

**BMD CONSULTING**  
Civil Engineers  
Structural Engineers  
& Project Managers  
ABN 23 010 743 002

Townsville Office  
57 Mitchell Street,  
Townsville  
P.O. Box 6008  
Townsville QC, QLD 4810  
Ph: (07) 4750 7000  
Fax: (07) 4758 7077  
Email: bmd@bmd.com.au  
www.bmd.com.au

Head Office - Brisbane  
Ph: (07) 3893 1511  
Sydney Office  
Ph: (02) 9858 5400  
Cairns Office  
Ph: (07) 4635 5444

Design	AM	Client	<b>URBEX PTY LTD</b>	
Drawn	AM		<b>KALYNDAL STAGE 5C</b>	
Checked	JL	Project	<b>EARTHWORKS LAYOUT PLAN</b>	
Original Approved By:	<i>[Signature]</i>		<b>SHEET 2 OF 2</b>	
RPEQ No.	6948	Title	<b>AS CONSTRUCTED</b>	
Date	MAY 2008		Drawing No. <b>CT1403-302</b> Rev <b>A</b>	