



BRAZIER MOTTI PTY LTD. ACN 066 411 041  
 595 FLINDERS ST. TOWNVILLE, HEREBY CERTIFY THAT  
 THIS DRAWING ACCURATELY AND CORRECTLY DESCRIBES  
 AND RECORDS THE NATURE AND LOCATION OF THE WORKS  
 DEPICTED BY ASTERISKS HEREON AS THEY HAVE BEEN  
 CONSTRUCTED FOR SUBMISSION  
 COMMON  
 LICENCED SURVEYOR & DIRECTOR  
 Dated this 17 day of 12, 2009  
 SEAL OF  
 ACN 066 411 041


**LEGEND**  
 DENOTES BATTER TO EXIST.  
 AT 1 IN 6 SLOPE  
 AS CONSTRUCTED EARTHWORKS LEVEL

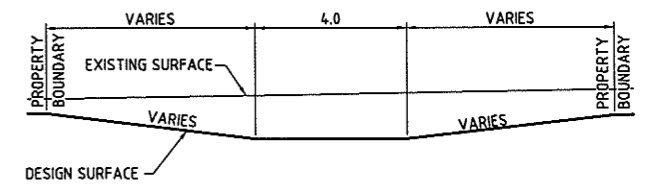

**SWALE SECTION - A**  
 NOT TO SCALE

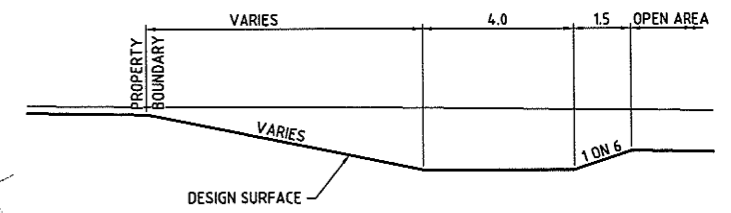


**SWALE SECTION - B**  
 NOT TO SCALE

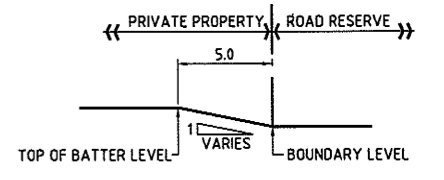

**FRONT BATTER DETAIL**  
 NOT TO SCALE

**NOTE**  
 DESIGN LEVELS SHOWN INSIDE OF PARKS AND AT  
 BOTTOM OF BATTERS IN PARKS WERE LOWERED  
 BY 100mm FOR BULK EARTHWORKS TO ALLOW  
 FOR TOPSOIL AND TURF BY LANDSCAPING  
 CONTRACTOR

**DATUM**  
 PM No.131651 LOCATED ON  
 HERVEY RANGE ROAD (BOLT IN BITUMEN)  
 RL 19.248m AHD

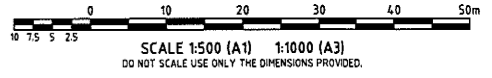

FOR CONTINUATION REFER DRAWING CT-1560-103

User: STRATTON JACOBSEN Name: JACT-1560 - 1560/CT-1560 - Kalynda Chase Stage 6B L1 CIVE - 1560/CT-1560 AS CON-1560-AS CON-1560

No.	Amendments	Drawn	Design	Appd	Certified	Reg No.	Date
B	EARTHWORKS LEVELS ADDED	S.J.J.	E.J.C.	[Signature]		5948	17.12.09
A	ORIGINAL ISSUE	S.J.J.	E.J.C.	[Signature]		9310	28.10.09

**kalynda chase** **urbex**

**BMD consulting**  
 Civil Engineers • Structural Engineers • Project Managers • Water Servicing Co-ordinators  
 brisbane • calms • canberra • gladstone • gold coast • mackay • sydney • townsville

Client **URBEX PTY LTD**  
 Project **KALYNDIA CHASE STAGE 6B**  
 Title **EARTHWORKS MANAGEMENT LAYOUT PLAN (SHEET 1 OF 2)**

Datum **AHD**  
 PSM **131651**  
 RL **19.248**  
**AH**  
 Project No. **CT-1560-102**  
 Drawing No. **AS CONSTRUCTED**  
 Rev **B**