



WATER LEGEND

- WATER MAIN
- 63 OD POLYETHYLENE LOOP MAIN
- FH
- SV
- GV
- TEE
- END CAP
- WATER SERVICE WITH ENVELOPER
- Ex. WATER
- EXIST. WATER MAIN
- Ex. WATER (POLY)
- LIMIT OF WORKS - STAGE 2


WATER NOTES

1. ALL WATER MAINS ARE LOCATED 1.2m ALIGNMENT OFFSET FROM PROPERTY BOUNDARIES UNLESS SHOWN OTHERWISE
2. THIS DRAWING IS TO BE READ IN CONJUNCTION WITH CITY OF THURINGOWA STANDARD DRAWINGS (WATER)
3. ALL UPVC MAINS TO BE SERIES 2, PN16 TO AS/NZS 1477 RUBBER RING JOINTED, WITH SOCKETED D.I.C.L. FITTINGS U.N.D.
4. CONNECTION TO EXISTING THURINGOWA COUNCIL WATER MAINS WAS CARRIED OUT BY THE CONTRACTOR UNDER COUNCIL SUPERVISION
5. CONNECTION TO EXISTING NO WATER MAINS WAS CARRIED OUT BY NO WATER AT THE CONTRACTOR'S EXPENSE.

BRAZIER MOTTI PTY LTD. ACN 066 411 041
 595 FLINDERS ST. TOWNSVILLE, HEREBY CERTIFY THAT THIS DRAWING ACCURATELY AND CORRECTLY DESCRIBES AND RECORDS THE NATURE AND LOCATION OF THE WORKS DEPICTED BY ASTERISKS (*) THEREON AS THEY HAVE BEEN CONSTRUCTED BY THIS DIVISION.



PM No. 131651 LOCATED ON HERVEY RANGE ROAD (BOLT IN BITUMEN) RL 19.248

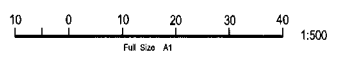

File Name: A:\CT-1171-225 - 2202\CT-1171 - Kalynda Chase Stage 2\Thuringowa\AS CONSTRUCTION\KALY-CT-1171-225.dwg
 User: BMD\BMD

No.	Amendments	By	Appd	Date	No.	Amendments	By	Appd	Date
A	ORIGINAL ISSUE	JAM		28.08.06					



BMD CONSULTING
 Civil Engineers
 Structural Engineers
 & Project Managers
 ABN 23 010 743 002

Townsville Office: 57 Mitchell Street, Townsville, P.O. Box 6900
 Phone: (07) 4750 7900, (07) 4750 7077, (07) 4750 7077
 Email: bmd@bmdconsulting.com.au, bmd@bmd.com.au

Head Office - Brisbane
 Phone: (07) 3893 1511
 Cairns Office
 Phone: (07) 2989 5400

Design	—
Drawn	JAM
Checked	PAV
Original Approved By:	<i>[Signature]</i>
RPEQ No.	
Date	AUGUST '06
Datum	A.H.D.

Client: **URBEX PTY LTD**
 Project: **KALYNDIA CHASE - STAGE 2**
 Title: **WATER RETICULATION LAYOUT PLAN**
SHEET 1 OF 4

AS CONSTRUCTED	Rev
Drawing No. CT-1171-224	





WATER LEGEND

- WATER MAIN
- - - 63 OD POLYETHYLENE LOOP MAIN
- FH FIRE HYDRANT
- SV SLUICE VALVE
- GV GATE VALVE
- TEE
- END CAP
- WATER SERVICE WITH ENVELOPER
- Ex. WATER EXIST. WATER MAIN
- Ex. WATER (POLY) EXIST. WATER MAIN (POLY)
- LIMIT OF WORKS - STAGE 2

WATER NOTES

1. ALL WATER MAINS ARE LOCATED 1.2m ALIGNMENT OFFSET FROM PROPERTY BOUNDARIES UNLESS SHOWN OTHERWISE
2. THIS DRAWING IS TO BE READ IN CONJUNCTION WITH CITY OF THURINGOWA STANDARD DRAWINGS (WATER).
3. ALL uPVC MAINS TO BE SERIES 2, PN16 TO AS/NZS 1477 RUBBER RING JOINTED, WITH SOCKETED D.I.C.L. FITTINGS UNO.
4. CONNECTION TO EXISTING THURINGOWA COUNCIL WATER MAINS WAS CARRIED OUT BY THE CONTRACTOR UNDER COUNCIL SUPERVISION
5. CONNECTION TO EXISTING NO WATER MAINS WAS CARRIED OUT BY NO WATER AT THE CONTRACTOR'S EXPENSE.

BRAZIER MOTTPIE LTD. ACN 066 411 041
 595 FLINDERS ST. TOWNSVILLE, HEREBY CERTIFY THAT THIS DRAWING ACCURATELY AND CORRECTLY DESCRIBES AND RECORDS THE NATURE AND LOCATION OF THE WORKS DEPICTED BY THIS DRAWING PROVIDED AS THEY HAVE BEEN CONSTRUCTED TO THE BEST OF OUR KNOWLEDGE AND BELIEF.

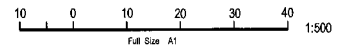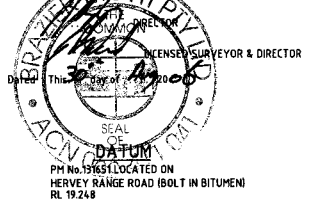

FOR CONTINUATION REFER DWG. CT-1171-227

File Name: D:\CT-1171-226\DWG\CT-1171-226.dwg User: JAM Date: 29/08/06

No.	Amendments	By	Appd	Date	No.	Amendments	By	Appd	Date
A	ORIGINAL ISSUE	JAM		29.08.06					



BMD CONSULTING
 Civil Engineers
 Structural Engineers
 & Project Managers
 AML 23 010 743 692

Townsville Office: ST Michael Street, Townsville, P.O. Box 6008, Townsville, MC, QLD 4810
 Ph: (07) 4750 7000, Fax: (07) 4750 7077, email: bmd.enq@bmd.com.au
 Head Office - Brisbane: Ph: (07) 3893 1511, Fax: (07) 4598 5400, Ph: (07) 4598 5444
 Cairns Office: Ph: (07) 4598 5444

Design	JAM
Drawn	JAM
Checked	PT
Original Approved By:	JAM
RPEQ No.	5555
Date	AUGUST '06
Datum	A.H.D.

Client: **URBEX PTY LTD**
 Project: **KALYNDA CHASE - STAGE 2**
 Title: **WATER RETICULATION LAYOUT PLAN SHEET 2 OF 4**

As Constructed
 Drawing No. **CT-1171-225**
 Rev **A**





WATER LEGEND

	WATER MAIN
	63 OD POLYETHYLENE LOOP MAIN
	FH FIRE HYDRANT
	SV SLUICE VALVE
	GV GATE VALVE
	TEE
	END CAP
	WATER SERVICE WITH ENVELOPER
	Ex. WATER EXIST. WATER MAIN
	Ex. WATER (POLY) EXIST. WATER MAIN (POLY)
	LIMIT OF WORKS - STAGE 2

- WATER NOTES**
1. ALL WATER MAINS ARE LOCATED 1.2m ALIGNMENT OFFSET FROM PROPERTY BOUNDARIES UNLESS SHOWN OTHERWISE.
 2. THIS DRAWING IS TO BE READ IN CONJUNCTION WITH CITY OF THURINGOWA STANDARD DRAWINGS (WATER).
 3. ALL uPVC MAINS TO BE SERIES 2, PN16 TO AS/NZS 1477 RUBBER RING JOINTED, WITH SOCKETED D.I.C.L. FITTINGS U.N.O.
 4. CONNECTION TO EXISTING THURINGOWA COUNCIL WATER MAINS WAS CARRIED OUT BY THE CONTRACTOR UNDER COUNCIL SUPERVISION.
 5. CONNECTION TO EXISTING NO. WATER MAINS WAS CARRIED OUT BY NO. WATER AT THE CONTRACTOR'S EXPENSE.

BRAZIER MOTTI PTY LTD. ACN 066 411 041
 595 FLINDERS ST. TOWNSVILLE, HEREBY CERTIFY THAT
 THIS DRAWING ACCURATELY AND CORRECTLY DESCRIBES
 AND RECORDS THE NATURE AND LOCATION OF THE WORKS
 DEPICTED BY ASTERISKS (*) HEREON AS THEY HAVE BEEN
 CONSTRUCTED FROM SUBDIVISION.

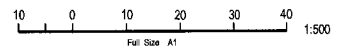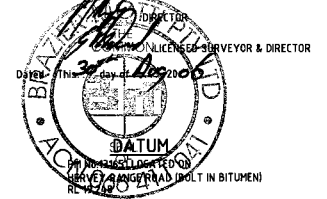

FOR CONTINUATION REFER DWG. CT-1171-225

No.	Amendments	By	Appd	Date	No.	Amendments	By	Appd	Date
A	ORIGINAL ISSUE	JAM		23.08.06					




BMD CONSULTING
 Civil Engineers
 Structural Engineers
 & Project Managers
 A/NZS 20 510 143 092

Townsville Office: 57 Mitchell Street, Townsville, P.O. Box 8908, Townsville, NC, QLD 4810
 Ph: (07) 4750 7000, Fax: (07) 4750 7077, email: bmd@bmd.com.au
 Brisbane Office: Ph: (07) 3893 1511, Sydney Office: Ph: (02) 9898 5400, Cairns Office: Ph: (07) 4395 1544

Design	JAM
Drawn	JAM
Checked	RAM
Original Approved By:	<i>[Signature]</i>
RPEQ No.	5555
Date	AUGUST '06
Datum	A.H.D.

Client	URBEX PTY LTD
Project	KALYNDIA CHASE - STAGE 2
Title	WATER RETICULATION LAYOUT PLAN SHEET 3 OF 4
AS CONSTRUCTED	
Drawing No.	CT-1171-226
Rev	A

File Name: J:\CT-1171-225 - 1000x1000 - 1000x1000 - 1000x1000.dwg
 User: JAM
 Date: 23/08/2006 10:41 AM

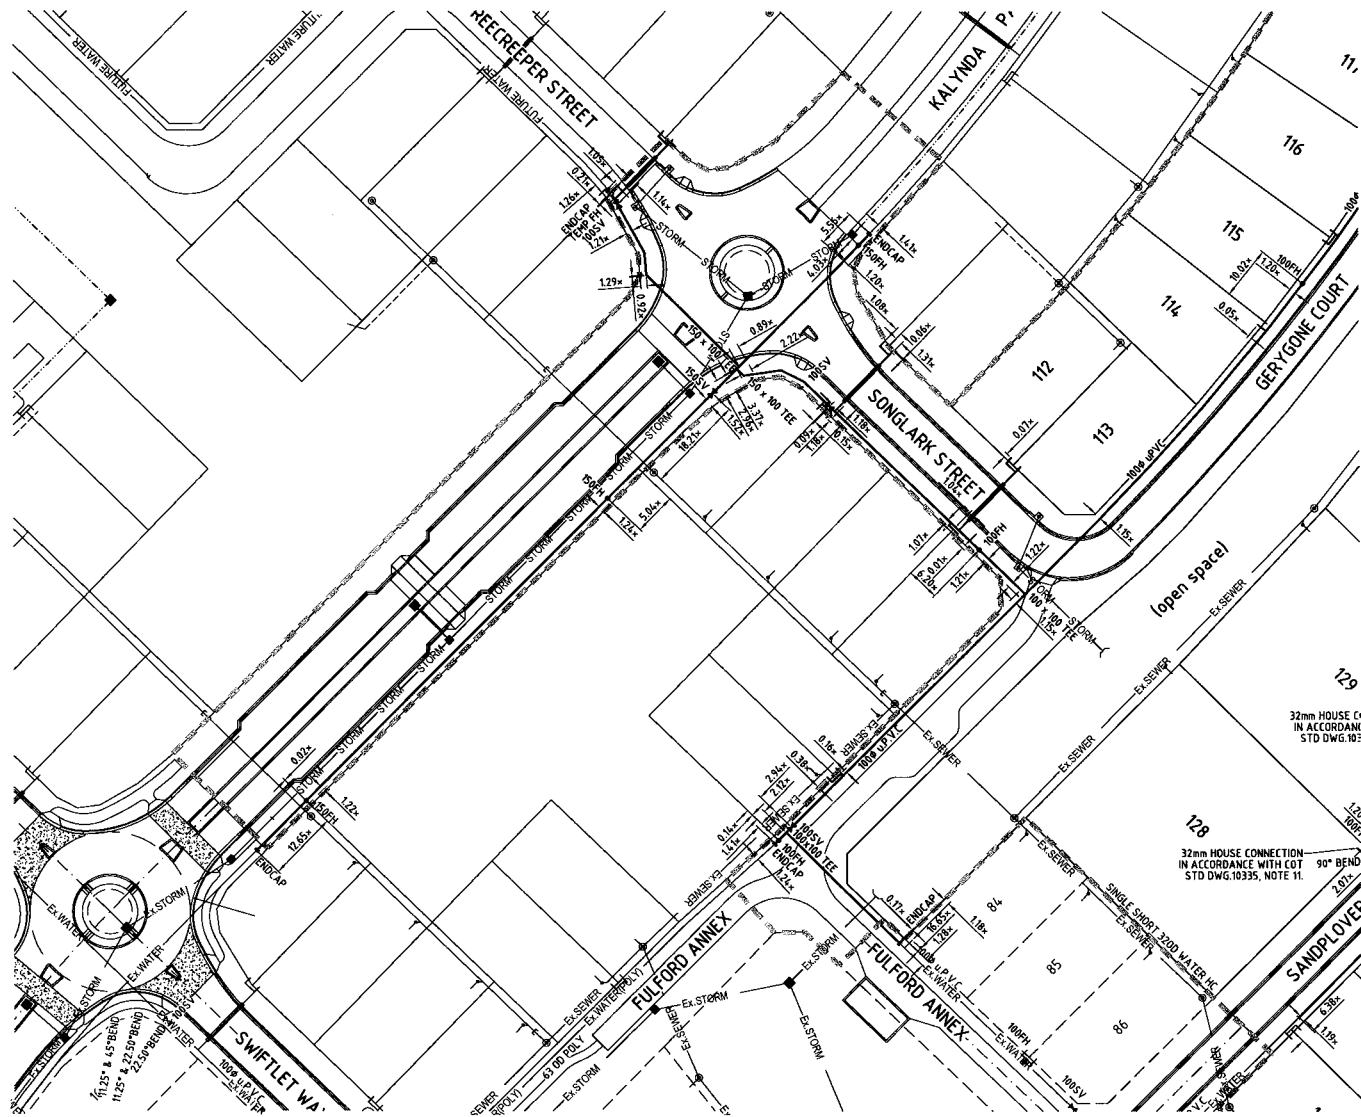



WATER LEGEND

- WATER MAIN
- - - 63 OD POLYETHYLENE LOOP MAIN
- FH — FIRE HYDRANT
- SV — SLUICE VALVE
- GV — GATE VALVE
- TEE
- END CAP
- WATER SERVICE WITH ENVELOPER
- Ex. WATER — EXIST. WATER MAIN
- Ex. WATER (POLY) — EXIST. WATER MAIN (POLY)
- LIMIT OF WORKS - STAGE 2

WATER NOTES

1. ALL WATER MAINS ARE LOCATED 1.2m ALIGNMENT OFFSET FROM PROPERTY BOUNDARIES UNLESS SHOWN OTHERWISE
2. THIS DRAWING IS TO BE READ IN CONJUNCTION WITH CITY OF THURINGOWA STANDARD DRAWINGS (WATER).
3. ALL uPVC MAINS TO BE SERIES 2, PN16 TO AS/NZS 1477 RUBBER RING JOINTED, WITH SOLKED D.I.C.L. FITTINGS U.N.D.
4. CONNECTION TO EXISTING THURINGOWA COUNCIL WATER MAINS WAS CARRIED OUT BY THE CONTRACTOR UNDER COUNCIL SUPERVISION
5. CONNECTION TO EXISTING NQ WATER MAINS WAS CARRIED OUT BY NQ WATER AT THE CONTRACTOR'S EXPENSE.

BRAZIER MOTTPY LTD. ACN 066 411 041
 595 FLINDERS ST. TOWNSVILLE. HEREBY CERTIFY THAT
 THIS DRAWING ACCURATELY AND CORRECTLY DESCRIBES
 AND RECORDS THE NATURE AND LOCATION OF THE WORKS
 DEPICTED BY ASTERISKS (*) HEREON AS THEY HAVE BEEN
 CONSTRUCTED FOR SUBMISSION

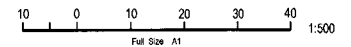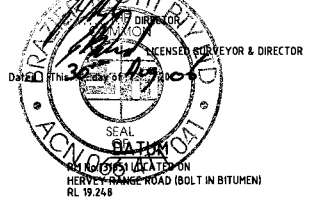

FOR CONTINUATION REFER DWG. CT-1171-225

File Name: J:\CT-1171-225 - SUBMIT-DWG - Kalynnda Chase - 430 - 2D\DWG\PLAN\CONSTRUCT\WATER.dwg

File Size: 8272055.165 KB, User: JAM, Date: 23/08/2016

No.	Amendments	By	Appd	Date	No.	Amendments	By	Appd	Date
A	ORIGINAL ISSUE	JAM		23.08.06					



BMD CONSULTING
 Civil Engineers
 Structural Engineers
 & Project Managers
 ABN 28 510 143 992

Townsville Office: 51 Mitchell Street, Townsville, P.O. Box 6068, Townsville, NC, QLD 4810
 Ph: (07) 4750 7000, Fax: (07) 4750 7077, email: bmd@bmd.com.au
 Brisbane Office: Cairns Office
 Ph: (07) 3993 1511, Ph: (07) 4255 1544

Design	JAM
Drawn	JAM
Checked	PAY
Original Approved By:	SSS
RPEQ No.	5555
Date	AUGUST '06
Datum	A.H.D.

Client	URBEX PTY LTD
Project	KALYNDA CHASE - STAGE 2
Title	WATER RETICULATION LAYOUT PLAN
	SHEET 4 OF 4
AS CONSTRUCTED	
Drawing No.	CT-1171-227
Rev	A