



### WATER NOTES

1. ALL WATER MAINS ARE LOCATED 1.2m ALIGNMENT OFFSET FROM PROPERTY BOUNDARIES UNLESS SHOWN OTHERWISE
2. THIS DRAWING WAS READ IN CONJUNCTION WITH CITY OF THURINGOWA STANDARD DRAWINGS (WATER).
3. ALL UPVC MAINS ARE SERIES 2, PN16 TO AS/NZS 1477 RUBBER RING JOINTED, WITH SOCKETED D.I.C.L. FITTINGS U.N.O.
4. CONNECTION TO EXISTING THURINGOWA COUNCIL WATER MAINS WERE CARRIED OUT BY THE CONTRACTOR UNDER COUNCIL SUPERVISION
5. CONNECTION TO EXISTING NQ WATER MAINS WERE CARRIED OUT BY NQ WATER AT THE CONTRACTOR'S EXPENSE.
6. CONTRACTOR VERIFIED ALL UNDERGROUND SERVICES WITH THE RELATIVE AUTHORITIES PRIOR TO ANY EXCAVATION

### DATUM

PM No.131651 LOCATED ON  
HERVEY RANGE ROAD (BOLT IN BITUMEN)  
RL 19.248m AHD

BRAZIER MOTTI PTY LTD. ACN 066 411 041  
595 FLINDERS ST. TOWNSVILLE, HEREBY CERTIFY THAT  
THIS DRAWING ACCURATELY AND CORRECTLY DESCRIBES  
AND RECORDS THE NATURE AND LOCATION OF THE WORKS  
DEPICTED BY ASTERISKS (\*) HEREON AS THEY HAVE BEEN  
CONSTRUCTED FOR SUBDIVISION.

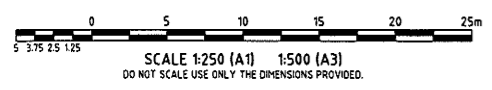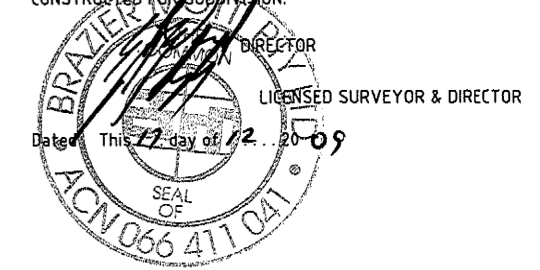

User: STRAITTON, JACOBSBHM Name: JACT-1590 - 1620UCT-1569 - Kalynda Stage 5D - DRGS V4.4 AS CONDUCT1569 - AS CON - WAP

No.	Amendments	Drawn	Design	Appd	Certified	Reg No.	Date
A	ORIGINAL ISSUE	S.J.J.	E.J.C.			5948	16.12.09

This drawing cannot be copied or reproduced in any form or used for any purpose other than that originally intended without the written permission of BMD Consulting Pty Ltd. © COPYRIGHT 2009



1st Floor,  
57 Mitchell Street North Ward QLD 4810  
PO Box 5306 Townsville MC QLD 4810  
P: 07 4750 7000 F: 07 4750 7077  
E: townsville@bmd.com.au  
www.bmd.com.au  
ABN 23 010 743 692

Civil Engineers • Structural Engineers • Project Managers • Water Servicing Co-ordinators  
brisbane • cairns • canberra • gladstone • gold coast • mackay • sydney • townsville

Client	URBEX PTY LTD
Project	KALYNDIA STAGE 5D
Title	WATER RETICULATION LAYOUT PLAN

Datum	AHD
PSM	131651
RL	19.248
(AMG) COORD	
AS CONSTRUCTED	
Project No.	CT-1569-CW101
Drawing No.	
Rev	A