


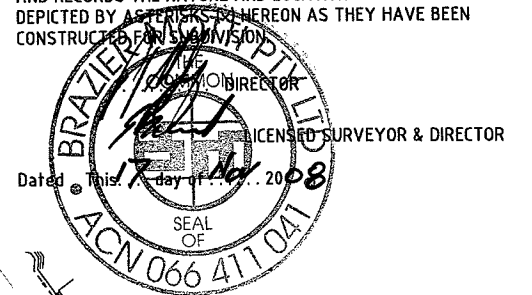

BRAZIER MOTTI PTY LTD. ACN 066 411 041
 595 FLINDERS ST. TOWNSVILLE, HEREBY CERTIFY THAT
 THIS DRAWING ACCURATELY AND CORRECTLY DESCRIBES
 AND RECORDS THE NATURE AND LOCATION OF THE WORKS
 DEPICTED BY AS PER THE HEREON AS THEY HAVE BEEN
 CONSTRUCTED BY THE ENGINEER



WATER LEGEND


- WATER MAIN
- 63 OD POLYETHYLENE LOOP MAIN
- FIRE HYDRANT
- SLUICE VALVE
- GATE VALVE
- TEE
- END CAP
- WATER SERVICE WITH ENVELOPER
- EXIST. WATER MAIN
- EXIST. WATER MAIN (POLY)
- FUTURE WATER MAIN

WATER NOTES



1. ALL WATER MAINS ARE LOCATED 1.2m ALIGNMENT OFFSET FROM PROPERTY BOUNDARIES UNLESS SHOWN OTHERWISE
2. THIS DRAWING WAS READ IN CONJUNCTION WITH CITY OF THURINGOWA STANDARD DRAWINGS (WATER).
3. ALL uPVC MAINS ARE SERIES 2, PN16 TO AS/NZS 1477 RUBBER RING JOINTED, WITH SOCKETED D.I.C.L. FITTINGS U.N.O.
4. CONNECTION TO EXISTING THURINGOWA COUNCIL WATER MAINS WERE CARRIED OUT BY THE CONTRACTOR UNDER COUNCIL SUPERVISION
5. CONNECTION TO EXISTING NO WATER MAINS WAS CARRIED OUT BY NO WATER AT THE CONTRACTOR'S EXPENSE.
6. CONTRACTOR HAS VERIFIED ALL UNDERGROUND SERVICES WITH THE RELEVANT AUTHORITIES PRIOR TO ANY EXCAVATION

DATUM

PM No.131651 LOCATED ON
 HERVEY RANGE ROAD (BOLT IN BITUMEN)
 RL 19.246m AHD

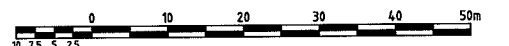

DO NOT SCALE, USE ONLY THE DIMENSIONS PROVIDED

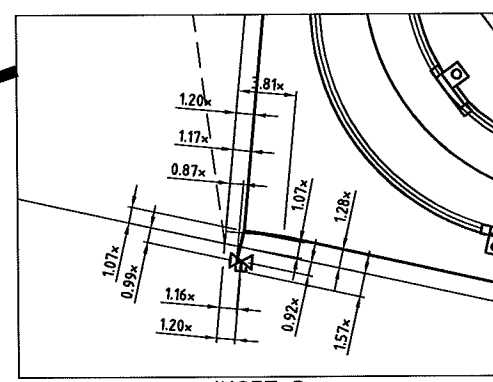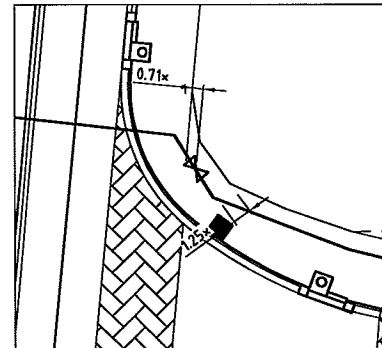

User: ALEXIS MORELLI File Name: JACT-930 - 14101CT-971 - Kalynda Chase - Stage 6 Drawings As Constructed - BT-AC-WAP Plot Date: 14/07/2008 2:58:27 PM

No.	Amendments	By	Appd	Date	No.	Amendments	By	Appd	Date
B	AMENDMENTS TO SUIT TCC LETTER 03.11.08	AM	JL	14.11.08					
A	ORIGINAL ISSUE	AM	JL	24.10.08					



BMD CONSULTING
 Civil Engineers, Structural Engineers & Project Managers
 ASB 23 010 743 892

Townsville Office: 57 Mitchell Street, Townsville, P.O. Box 6068, Townsville, QLD 4810
 Phone: (07) 4750 7000, Fax: (07) 4750 7077, Email: bmd@bmd.com.au, www.bmd.com.au

Head Office - Brisbane: 57 Mitchell Street, Brisbane, QLD 4000
 Phone: (07) 3893 1511

Sydney Office: Phone: (02) 9898 5400
 Cairns Office: Phone: (07) 4035 1544

Design	AM	Client	URBEX PTY. LTD.	
Drawn	JL	Project	KALYNDA CHASE STAGE 6A AS CONSTRUCTED	
Checked	JL	Title	WATER RETICULATION LAYOUT PLAN	
Original Approved By:	JL		AS CONSTRUCTED	
RPEQ No.	9310	Drawing No.	CT1371-111	
Date	JULY 08	Rev	B	
Datum	A.H.D.			

THIS DRAWING CANNOT BE COPIED OR REPRODUCED IN ANY FORM OR USED FOR ANY OTHER PURPOSE OTHER THAN THAT ORIGINALLY INTENDED WITHOUT THE WRITTEN PERMISSION OF BMD CONSULTING PTY LTD.