




WATER LEGEND

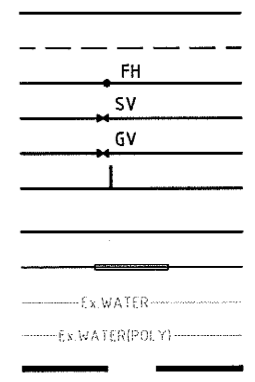


WATER NOTES

1. ALL WATER MAINS ARE LOCATED 1.2m ALIGNMENT OFFSET FROM PROPERTY BOUNDARIES UNLESS SHOWN OTHERWISE
2. THIS DRAWING WAS READ IN CONJUNCTION WITH CITY OF THURINGOWA STANDARD DRAWINGS (WATER).
3. ALL uPVC MAINS ARE SERIES 2, PN16 TO AS/NZS 1477 RUBBER RING JOINTED, WITH SOCKETED D.I.C.L. FITTINGS U.N.O.
4. CONNECTION TO EXISTING THURINGOWA COUNCIL WATER MAINS HAS BEEN CARRIED OUT BY THE CONTRACTOR UNDER COUNCIL SUPERVISION
5. CONNECTION TO EXISTING NQ WATER MAINS HAS BEEN CARRIED OUT BY NQ WATER AT THE CONTRACTOR'S EXPENSE.
6. CONTRACTOR HAS VERIFIED ALL UNDERGROUND SERVICES WITH THE RELEVANT AUTHORITIES PRIOR TO ANY EXCAVATION

BRAZIER MOTTI PTY LTD. ACN 066 411 041
 595 FLINDERS ST. TOWNSVILLE, HEREBY CERTIFY THAT THIS DRAWING ACCURATELY AND CORRECTLY DESCRIBES AND RECORDS THE NATURE AND LOCATION OF THE WORKS DEPICTED BY ASTERISKS (*) HEREON AS THEY HAVE BEEN CONSTRUCTED FOR SUBDIVISION.

DATED: This 17 day of 12, 2009

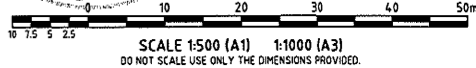

User: STRATTON JACOBS Name: JACT-100 - 100VCT-107 - Kalynda Chase - Stage 7B Drawing No: 100VCT-107-AC-WAP

No.	Amendments	Drawn	Design	Appd	Certified	Reg No.	Date
A	ORIGINAL ISSUE	S.J.J.	P.A.V.			5948	16.12.09



1st Floor,
 57 Mitchell Street North Ward QLD 4810
 PO Box 6008 Townsville MC QLD 4810
 P: 07 4750 7000 F: 07 4750 7077
 E: townsville@bmd.com.au
 www.bmd.com.au
 ABN 23 010 743 892

Client **URBEX PTY LTD**
 Project **KALYNDA CHASE STAGE 7B AS CONSTRUCTED**
 Title **WATER RETICULATION LAYOUT PLAN**

Datum **AHD**
 PSM **131851**
 RL **19.248**
(MGA) COORD
AS CONSTRUCTED
 Project No. Drawing No. Rev
CT1372-121 **A**

Civil Engineers • Structural Engineers • Project Managers • Water Servicing Co-ordinators
 brisbane • calms • canberra • gladstone • gold coast • mackay • sydney • townsville