






[illegible]

VISION SURVEYS (QLD) PTY LTD (ABN 84 128 752 947)  
SHOP 19/16 MAIN STREET, BURDELL.

DIRECTOR:  
03/12/2018  
DATE:

**MANHOLE DROP NOTE:**  
INTERNAL MH. DROPS AS PER  
TOWNSVILLE CITY COUNCIL  
STANDARD DRAWING SD-474

E	0.000	18.18x	16.11x	2.069x	
				2.027x	

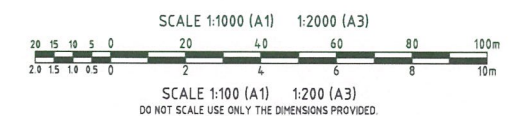

<i>Client</i>	<b>URBEX PTY LTD</b>	<i>Datum</i> <b>AHD</b>	
<i>Project</i>	<b>KALYNDA CHASE STAGE 11B3-2 AND 11C2</b>	<b>PSM NO.13165</b> <b>RL 19.248M</b> <b>(MGA) COORD</b>	
<i>Title</i>	<b>SEWERAGE RETICULATION LONGITUDINAL SECTION SHEET 1 OF 2</b>	<b>AS CONSTRUCTED</b>	
		<i>Project No.</i> <b>CT1521-CS202</b>	<i>Drawing No.</i> <b>1</b>



THE WORK ON THIS DRAWING HAS BEEN  
CONSTRUCTED GENERALLY IN  
ACCORDANCE WITH THE DESIGN  
DRAWINGS AND THE INTENT OF THE  
GUIDELINES OF TOWNSVILLE CITY COUNCIL

for and on behalf of  
Empower Engineer & Project Managers

**NOTE:-**  
REFER TCC STD DWG Nos. SD-455 TO SD-475  
FOR DETAILS OF SEWER MANHOLES, COVERS,  
FRAMES, INLETS, OUTLETS, HOUSE  
CONNECTIONS & PIPELINE CONSTRUCTION.

HEREBY CERTIFY ALL THE INFORMATION DENOTED IN RED  
THAT IS IN THIS DRAWING ACCURATELY AND CORRECTLY  
DESCRIBES AND RECORDS THE NATURE AND LOCATION OF  
THE WORKS DEPICTED BY ASTERISKS (\*) HEREON AS THEY  
HAVE BEEN CONSTRUCTED.

HEREBY CERTIFY ALL THE INFORMATION DENOTED IN GREEN  
THAT IS IN THIS DRAWING ACCURATELY AND CORRECTLY  
DESCRIBES AND RECORDS THE NATURE AND LOCATION OF  
THE WORKS DEPICTED BY ASTERISKS (\*) THEREON AS THEY  
HAVE BEEN CONSTRUCTED

DATE: \_\_\_\_\_

595 FLINDERS STREET TOWNSVILLE









HEREBY CERTIFY ALL THE INFORMATION DEMAND  
THAT IS IN THIS DRAWING ACCURATELY AND  
DESCRIBES AND RECORDS THE NATURE AND  
THE WORKS DEPICTED BY ASTERISKS, THAT THEY  
HAVE BEEN CONSTRUCTED

DIRECTOR

DATE

4/10/18

SEAL OF  
AC 66 411 041

HOUSE CONNECTION TYPES		
		TYPE A DIRECT CONN. (~0.5m)
		TYPE B JUMP-UP (~0.4-6m)
		TYPE C DIRECT CONN. HH (~0.5m)
		TYPE D INTERNAL DROP (~0.4-6m)

[illegible]

SCALE 1:1000 (A1) 1:2000 (A3)

20 15 10 5 0 20 40 60 80 100m

2.0 1.5 1.0 0.5 0 2 4 6 8 10m

SCALE 1:100 (A1) 1:200 (A3)

DO NOT SCALE USE ONLY THE DIMENSIONS PROVIDED

<i>Client</i>	URBEX PTY LTD	<i>Datum</i> AHD	
<i>Project</i>	KALYNDA CHASE STAGE 11B3-2 AND 11C2	PSM NO.131651	
		RL 19.248M	
		(MGA) COORD	
<i>Title</i>	SEWERAGE RETICULATION LONGITUDINAL SECTION SHEET 2 OF 2	<b>AS CONSTRUCTED</b>	
		<i>Project No.</i>	<i>Drawing No.</i>
		CT1521-CS203	2