

FOR CONTINUATION REFER DRAWING CT1521-CE302



1		AS CONSTRUCTED	JT	MM	CH	CH	13/10/20	22/10/2020	12732
No.		Amendments	Drawn	Design	Design	Chk	Appd	Date	Register
This drawing cannot be copied or reproduced in any form or used for any purpose other than that originally intended without the written permission of Empower Engineers and Project Managers ©COPYRIGHT 2018									



Empower
ENGINEERS &
PROJECT MANAGERS
ABN 23 010 743 692

Client	URBEX PTY LTD	Datum	AHD
Project	KALYNDIA CHASE STAGE 11B2, 11C3 AND 11C4	PSM	131651
Title	EARTHWORKS LAYOUT (SHEET 1 OF 2)	RL	19.248M (MGA) COORD
		AS CONSTRUCTED	
Project No.	CT1521-CE301	Drawing No.	1

AS CONSTRUCTED CERTIFICATION


THE WORK ON THIS DRAWING HAS BEEN CONSTRUCTED GENERALLY IN ACCORDANCE WITH THE DESIGN DRAWINGS AND THE INTENT OF THE GUIDELINES OF TOWNSVILLE CITY COUNCIL

APPROVED: *Chloe Webb* RPEQ: 12732

for and on behalf of Empower Engineer & Project Managers




BRAZIER MOTTI PTY LTD (ACN 066 411 041), 595 Flinders Street, Townsville hereby certify that this Drawing accurately and correctly describes and records the nature and location of the works depicted by asterisks as they have been constructed for subdivision.

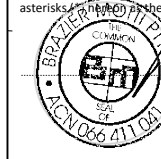


Date: 22-10-20

NOTE:-
REFER TO DRAWING CT1521-CE301 FOR
LEGEND AND NOTES

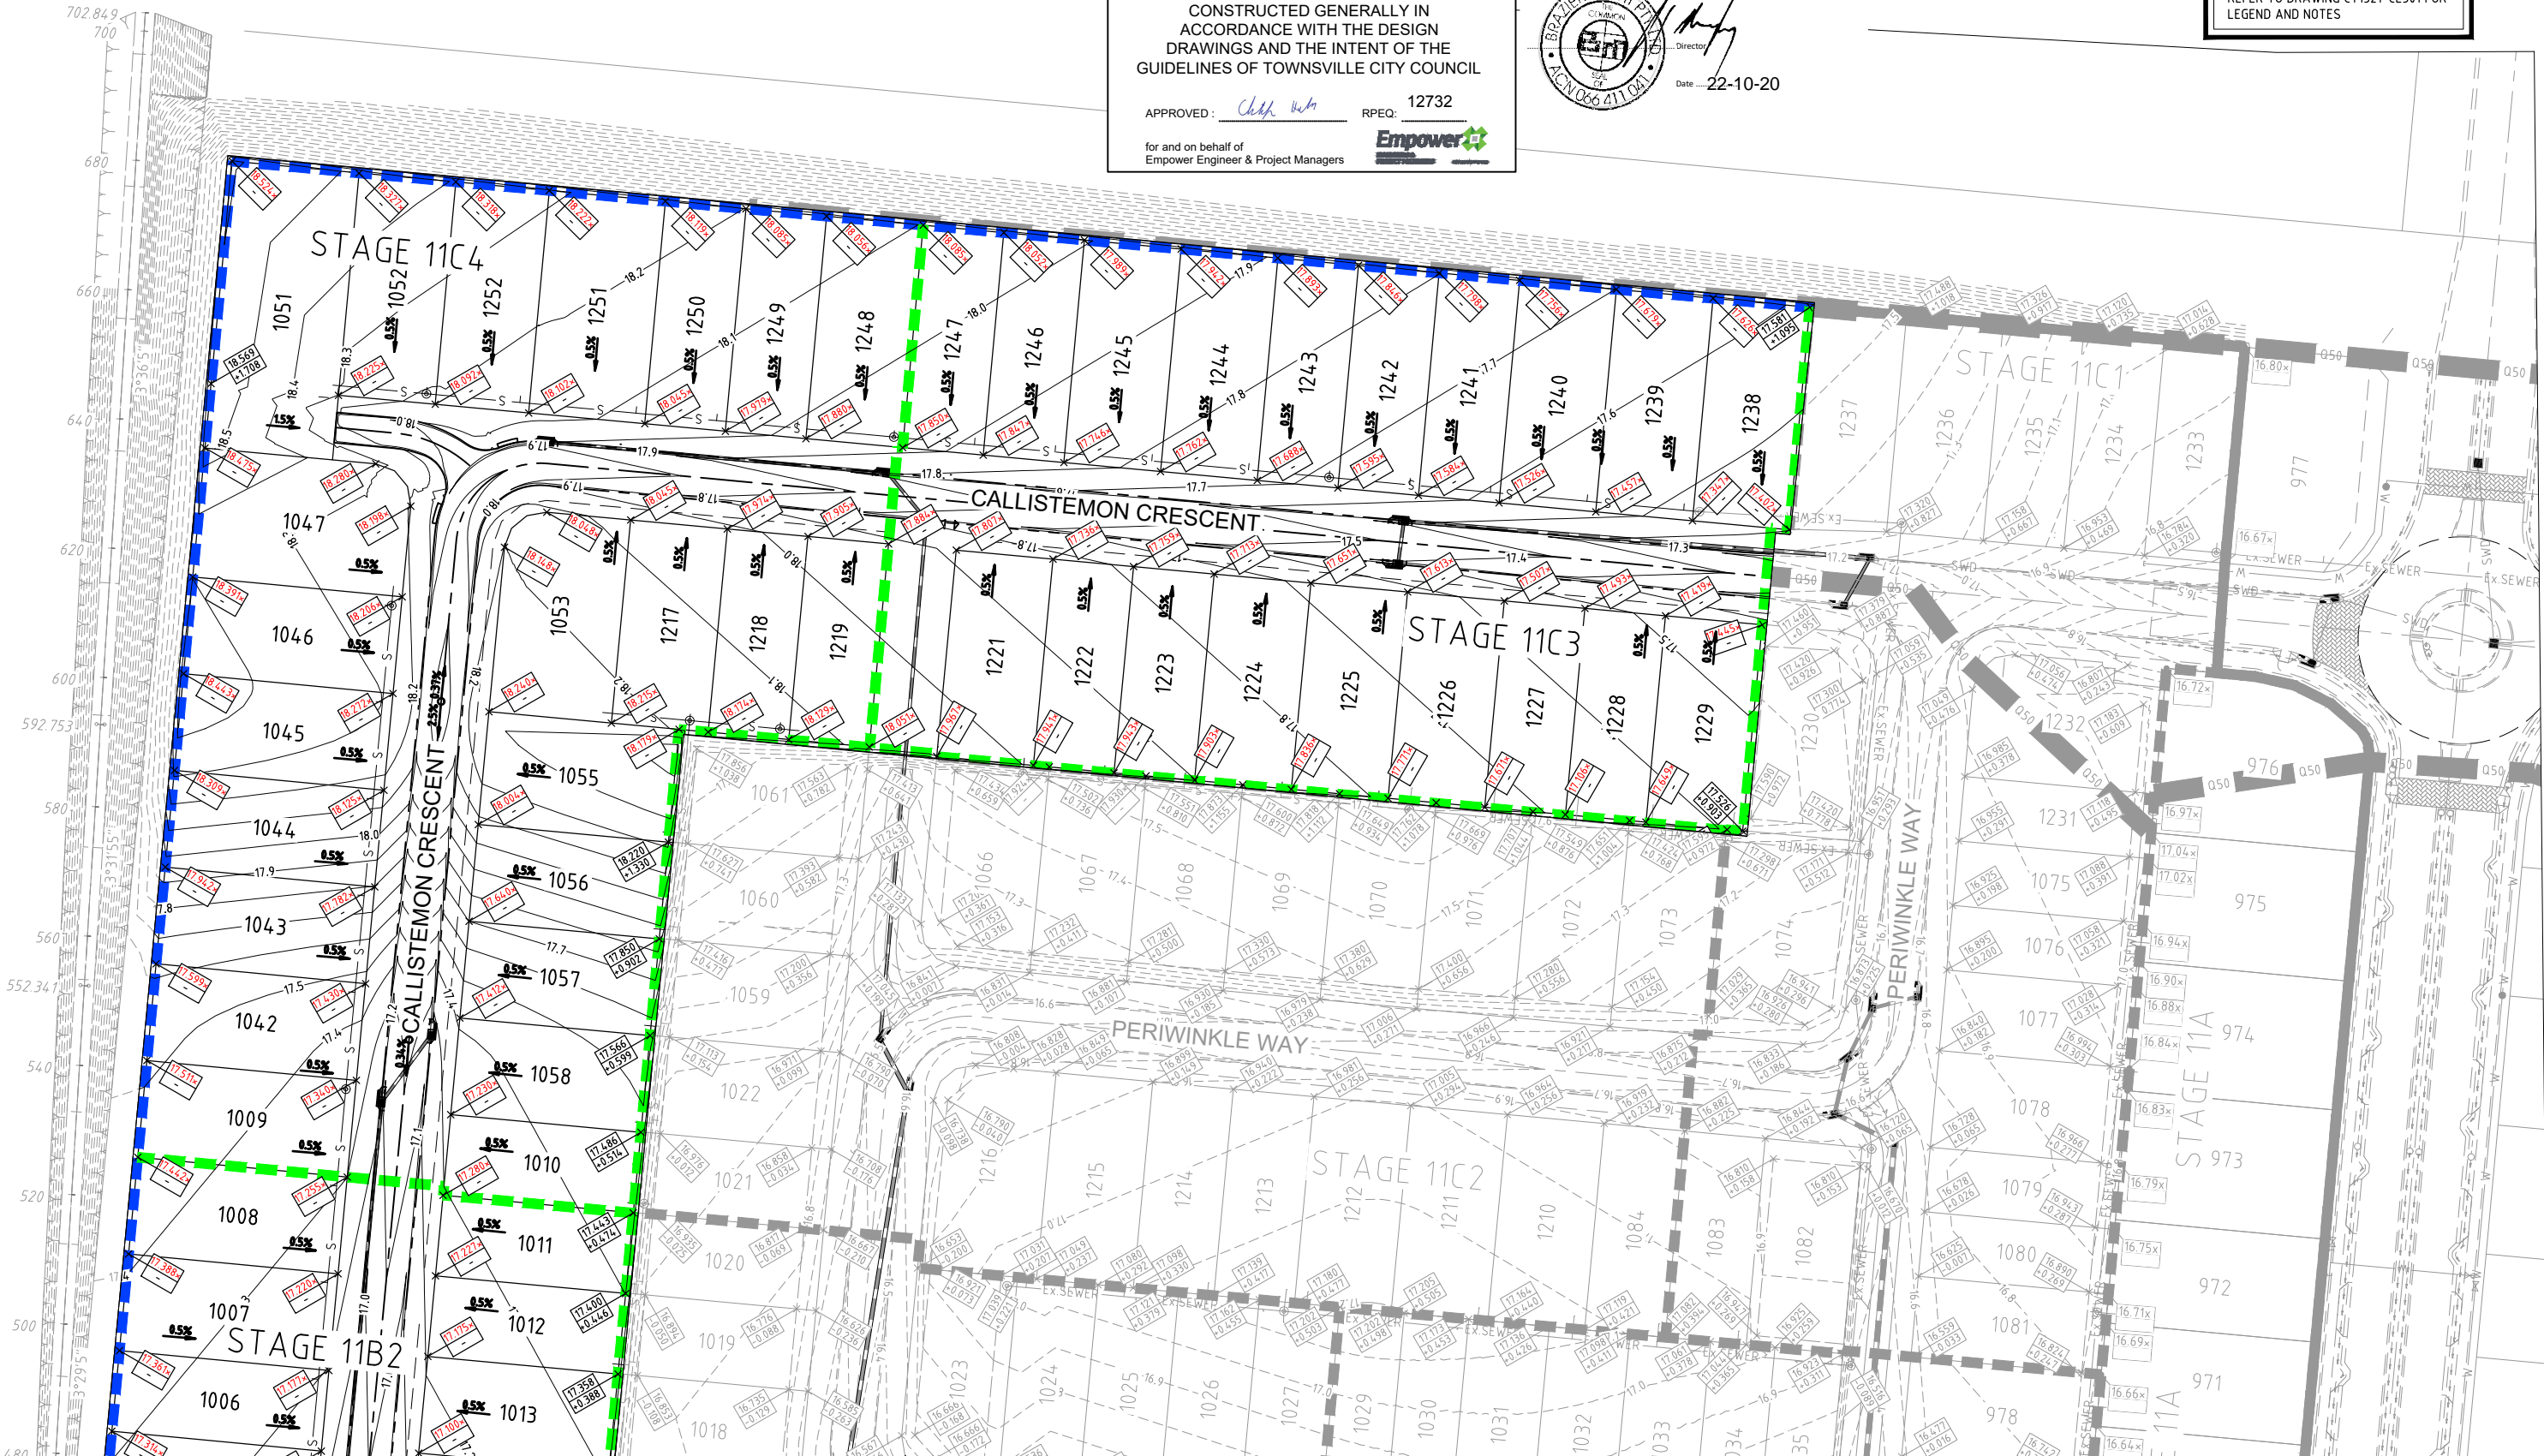


FOR CONTINUATION REFER DRAWING CT1521-CE301

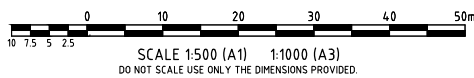

User: MARTY LATOBBE File Name: C:\Users\marty\Documents\1521.ctb Date: 22/10/2020 8:09:17 AM

1	AS CONSTRUCTED	JT	MM	CH	CH	13/10/20	12732	22/10/2020	Register
No.	Amendments	Drawn	Design	Design	Chk	Appd	Date	ENGINEERING CERTIFICATION	
This drawing cannot be copied or reproduced in any form or used for any purpose other than that originally intended without the written permission of Empower Engineers and Project Managers ©COPYRIGHT 2018									

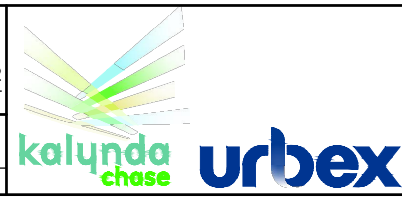

Client	URBEX PTY LTD	Datum	AHD
Project	KALYNDIA CHASE STAGE 11B2, 11C3 AND 11C4	PSM	131651
Title	EARTHWORKS LAYOUT (SHEET 2 OF 2)	RL	19.248M (MGA) COORD
		AS CONSTRUCTED	
Project No.		Drawing No.	
	CT1521-CE302	Rev	1