

FOR CONTINUATION REFER DRAWING CT1521-CE102



LOCALITY PLAN
NOT TO SCALE

LEGEND

- EARTHWORKS GRADE CHANGE
- STAGE BOUNDARY
- FSL = EXISTING STAGE FINISHED SURFACE LEVEL
- ASL = AS CONSTRUCTED SURFACE LEVEL

AS CONSTRUCTED CERTIFICATION

THE WORK ON THIS DRAWING HAS BEEN CONSTRUCTED GENERALLY IN ACCORDANCE WITH THE DESIGN DRAWINGS AND THE INTENT OF THE GUIDELINES OF TOWNSVILLE CITY COUNCIL

APPROVED: *Cheryl Helm* RPEQ: 12732


for and on behalf of Empower Engineer & Project Managers

BRAZIER MOTTL PTY LTD (ACN 066 411 041)
595 FLINDERS STREET, TOWNSVILLE

HEREBY CERTIFY THAT THIS DRAWING ACCURATELY AND CORRECTLY DESCRIBES AND RECORDS THE NATURE AND LOCATION OF THE WORKS DEPICTED BY ASTERISKS (*) HEREON AS THEY HAVE BEEN CONSTRUCTED.

DIRECTOR

DATE: 10/03/17

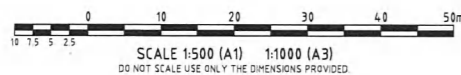

Plot Date: 10/03/2017 2:33:34 PM User: JDSJ TURNOCK File Name: C:\empower\1521\1521_2\AS ASL.dwg VLS to com\CT1521-AS CON 11045

1	AS CONSTRUCTED	JT	JK	CH	<i>Cheryl Helm</i>	12732	17/03/17
No.	Amendments	Drawn	Design	Appd	Registered Engineer	Reg No.	Date

This drawing cannot be copied or reproduced in any form or used for any purpose other than that originally intended without the written permission of Empower Engineers and Project Managers © COPYRIGHT 2017



Client	URBEX PTY LTD
Project	KALYNDA CHASE STAGE 11B3 AND 11C1
Title	EARTHWORKS LAYOUT (SHEET 1 OF 2)

Datum	AHD	
PSM NO.	131651	
RL	19.248M	
(MGA) COORD		
AS CONSTRUCTED		
Project No.	CT1521-CE101	Rev
Drawing No.		1