


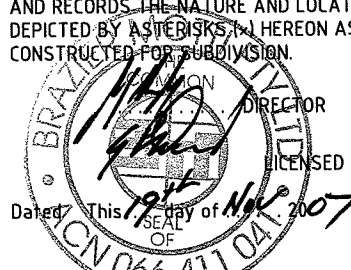

BRAZIER MOTTI PTY LTD. ACN 066 411 041
 595 FLINDERS ST. TOWNSVILLE, HEREBY CERTIFY THAT
 THIS DRAWING ACCURATELY AND CORRECTLY DESCRIBES
 AND RECORDS THE NATURE AND LOCATION OF THE WORKS
 DEPICTED BY ASTERISKS (*) HEREON AS THEY HAVE BEEN
 CONSTRUCTED FOR SUBDIVISION.



WATER LEGEND


- WATER MAIN
- - - 63 OD POLYETHYLENE LOOP MAIN
- FH FIRE HYDRANT
- SV SLUICE VALVE
- GV GATE VALVE
- TEE
- END CAP
- WATER SERVICE WITH ENVELOPER
- Ex.WATER EXIST. WATER MAIN
- Ex.WATER(POLY) EXIST. WATER MAIN (POLY)
- - - - - LIMIT OF WORKS - STAGE 4

WATER NOTES

1. ALL WATER MAINS LOCATED 1.2m ALIGNMENT OFFSET FROM PROPERTY BOUNDARIES UNLESS SHOWN OTHERWISE
2. THIS DRAWING IS TO BE READ IN CONJUNCTION WITH CITY OF THURINGOWA STANDARD DRAWINGS (WATER).
3. ALL uPVC MAINS ARE SERIES 2, PN16 TO AS/NZS 1477 RUBBER RING JOINTED, WITH SOCKETED D.I.C.L. FITTINGS U.N.O.
4. CONNECTION TO EXISTING THURINGOWA COUNCIL WATER MAINS CARRIED OUT BY THE CONTRACTOR UNDER COUNCIL SUPERVISION

DATUM

PM No.131651 LOCATED ON
 HERVEY RANGE ROAD (BOLT IN BITUMEN)
 RL 19.248

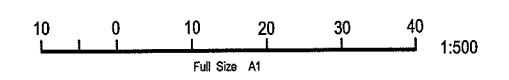

No.	Amendments	By	Appd	Date	No.	Amendments	By	Appd	Date
A	ORIGINAL ISSUE	S.J.J		14/11/07					

Civil Engineers
 Structural Engineers
 Project Managers
BMD CONSULTING
 Townsville Office: 57 Mitchell Street, Townsville, P.O. Box 5008, Townsville MC, QLD 4810
 Ph: (07) 4750 7000, Fax: (07) 4758 7017, email: bmdcons@bmd.com.au, www.bmd.com.au
 Head Office - Brisbane: Ph: (07) 3883 1511, Sydney Office: Ph: (02) 9898 5400

Design	S.J.J	Client	URBEX Pty Ltd
Drawn	W.E.S	Project	KALYNDIA CHASE - STAGE 4
Checked		Title	AS CONSTRUCTED
Original Approved By:			WATER RETICULATION LAYOUT PLAN
RPEQ No.	5948		SHEET 2 OF 3
Date	NOV '07		Drawing No. CT-1173-517
Datum	A.H.D.		Rev A

THIS DRAWING CANNOT BE COPIED OR REPRODUCED IN ANY FORM OR USED FOR ANY OTHER PURPOSE OTHER THAN THAT ORIGINALLY INTENDED WITHOUT THE WRITTEN PERMISSION OF BMD CONSULTING PTY LTD.