



INSET A

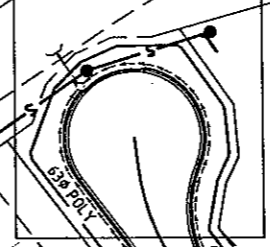

INSET B

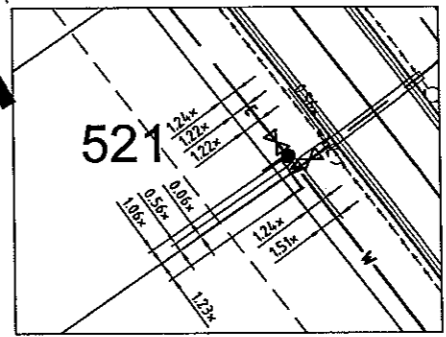

INSET C

WATER LEGEND


- WATER MAIN
- 63 OD POLYETHYLENE LOOP MAIN
- FH FIRE HYDRANT
- SV SLUICE VALVE
- GV GATE VALVE
- TEE
- END CAP
- WATER SERVICE WITH ENVELOPER
- EXIST. WATER MAIN
- EXIST. WATER MAIN (POLY)

WATER NOTES

1. ALL WATER MAINS ARE LOCATED 1.2m ALIGNMENT OFFSET FROM PROPERTY BOUNDARIES UNLESS SHOWN OTHERWISE
2. THIS DRAWING HAS BEEN READ IN CONJUNCTION WITH CITY OF THURINGOWA STANDARD DRAWINGS (WATER)
3. ALL UPVC MAINS ARE SERIES 2, PN16 TO AS/NZS 1477 RUBBER RING JOINTED, WITH SOCKETED D.I.C.L. FITTINGS U.N.O.
4. CONNECTION TO EXISTING THURINGOWA COUNCIL WATER MAINS WERE CARRIED OUT BY THE CONTRACTOR UNDER COUNCIL SUPERVISION
5. CONNECTION TO EXISTING NQ WATER MAINS WERE CARRIED OUT BY NQ WATER AT THE CONTRACTOR'S EXPENSE.

DATUM

PM No.131651 LOCATED ON HERVEY RANGE ROAD (BOLT IN BITUMEN) RL 19.248m AHD

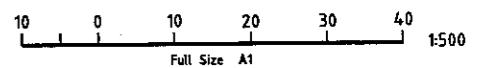

BRAZIER MOTTI PTY LTD. ACN 066 411 041
 595 FLINDERS ST. TOWNSVILLE, HEREBY CERTIFY THAT THIS DRAWING ACCURATELY AND CORRECTLY DESCRIBES AND RECORDS THE NATURE AND LOCATION OF THE WORKS DEPICTED BY ASTERISKS THEREON AS THEY HAVE BEEN CONSTRUCTED FOR SUBDIVISION



Date: 21/07/2008 10:51 PM
 User: ALEXIS MORELLI
 File Name: J:\CT-1403 - 1403 - Kalynda Chase Stage 5B - 5B\Drawings\1403.ctb
 Plot Style: AS CONSTRUCTION.ctb
 Plot Device: HP DesignJet 540

No.	Amendments	By	Appd	Date	No.	Amendments	By	Appd	Date
A	ORIGINAL ISSUE	AM		22.07.08					

BMD CONSULTING
 Civil Engineers
 Structural Engineers
 & Project Managers
 ABN 23 010 743 692

Townsville Office: 57 Midwell Street, Townsville, P.O. Box 6906, Townsville, QLD 4810
 Phone: (07) 4750 7000, Fax: (07) 4750 7077, Email: bmd.cons@bmd.com.au, www.bmd.com.au

Head Office - Brisbane: 100 St George Street, Brisbane, QLD 4000
 Phone: (07) 3893 1511

Sydney Office: 100 St George Street, Sydney, NSW 2000
 Phone: (02) 9892 5400

Calms Office: 100 St George Street, Cairns, QLD 4870
 Phone: (07) 4935 5444

Design	AM
Drawn	JL
Checked	JL
Original Approved By:	JL
RPEQ No.	9948
Date	JULY 2008

URBEX PTY LTD
KALYNDIA STAGE 5B
WATER RETICULATION PLAN
SHEET 1 OF 2

AS CONSTRUCTED
 Drawing No. CT-1403-215
 Rev A

WATER LEGEND


- WATER MAIN
- - - 63 OD POLYETHYLENE LOOP MAIN
- FH FIRE HYDRANT
- SV SLUICE VALVE
- GV GATE VALVE
- TEE
- END CAP
- WATER SERVICE WITH ENVELOPER
- EXIST. WATER MAIN
- EXIST. WATER MAIN (POLY)

WATER NOTES




1. ALL WATER MAINS ARE LOCATED 1.2m ALIGNMENT OFFSET FROM PROPERTY BOUNDARIES UNLESS SHOWN OTHERWISE
2. THIS DRAWING HAS BEEN READ IN CONJUNCTION WITH CITY OF THURINGOWA STANDARD DRAWINGS (WATER).
3. ALL UPVC MAINS ARE SERIES 2, PN16 TO AS/NZS 1477 RUBBER RING JOINTED, WITH SOCKETED D.I.C.L. FITTINGS U.N.O.
4. CONNECTION TO EXISTING THURINGOWA COUNCIL WATER MAINS WERE CARRIED OUT BY THE CONTRACTOR UNDER COUNCIL SUPERVISION
5. CONNECTION TO EXISTING NQ WATER MAINS WERE CARRIED OUT BY NQ WATER AT THE CONTRACTOR'S EXPENSE.




BRAZIER MOTTI PTY LTD ACN 066 411 041
 595 FLINDERS ST, TOWNSVILLE, HEREBY CERTIFY THAT
 THIS DRAWING ACCURATELY AND CORRECTLY DESCRIBES
 AND RECORDS THE NATURE AND LOCATION OF THE WORKS
 DEPICTED BY ASTERISKS (*) HEREON AS THEY HAVE BEEN
 CONSTRUCTED FOR SUBDIVISION.

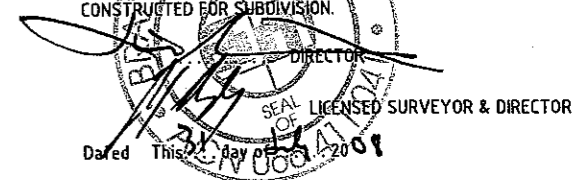

DATUM
 PM No. 131651 LOCATED ON
 HERVEY RANGE ROAD (BOLT IN BITUMEN)
 RL 19.248m AHD

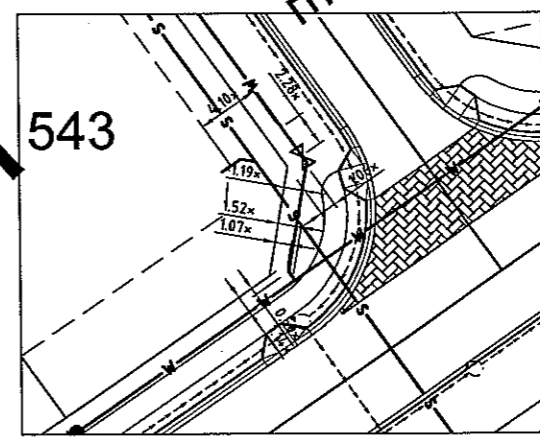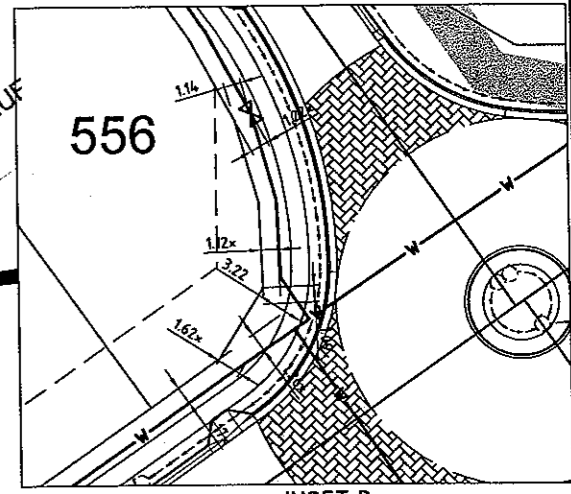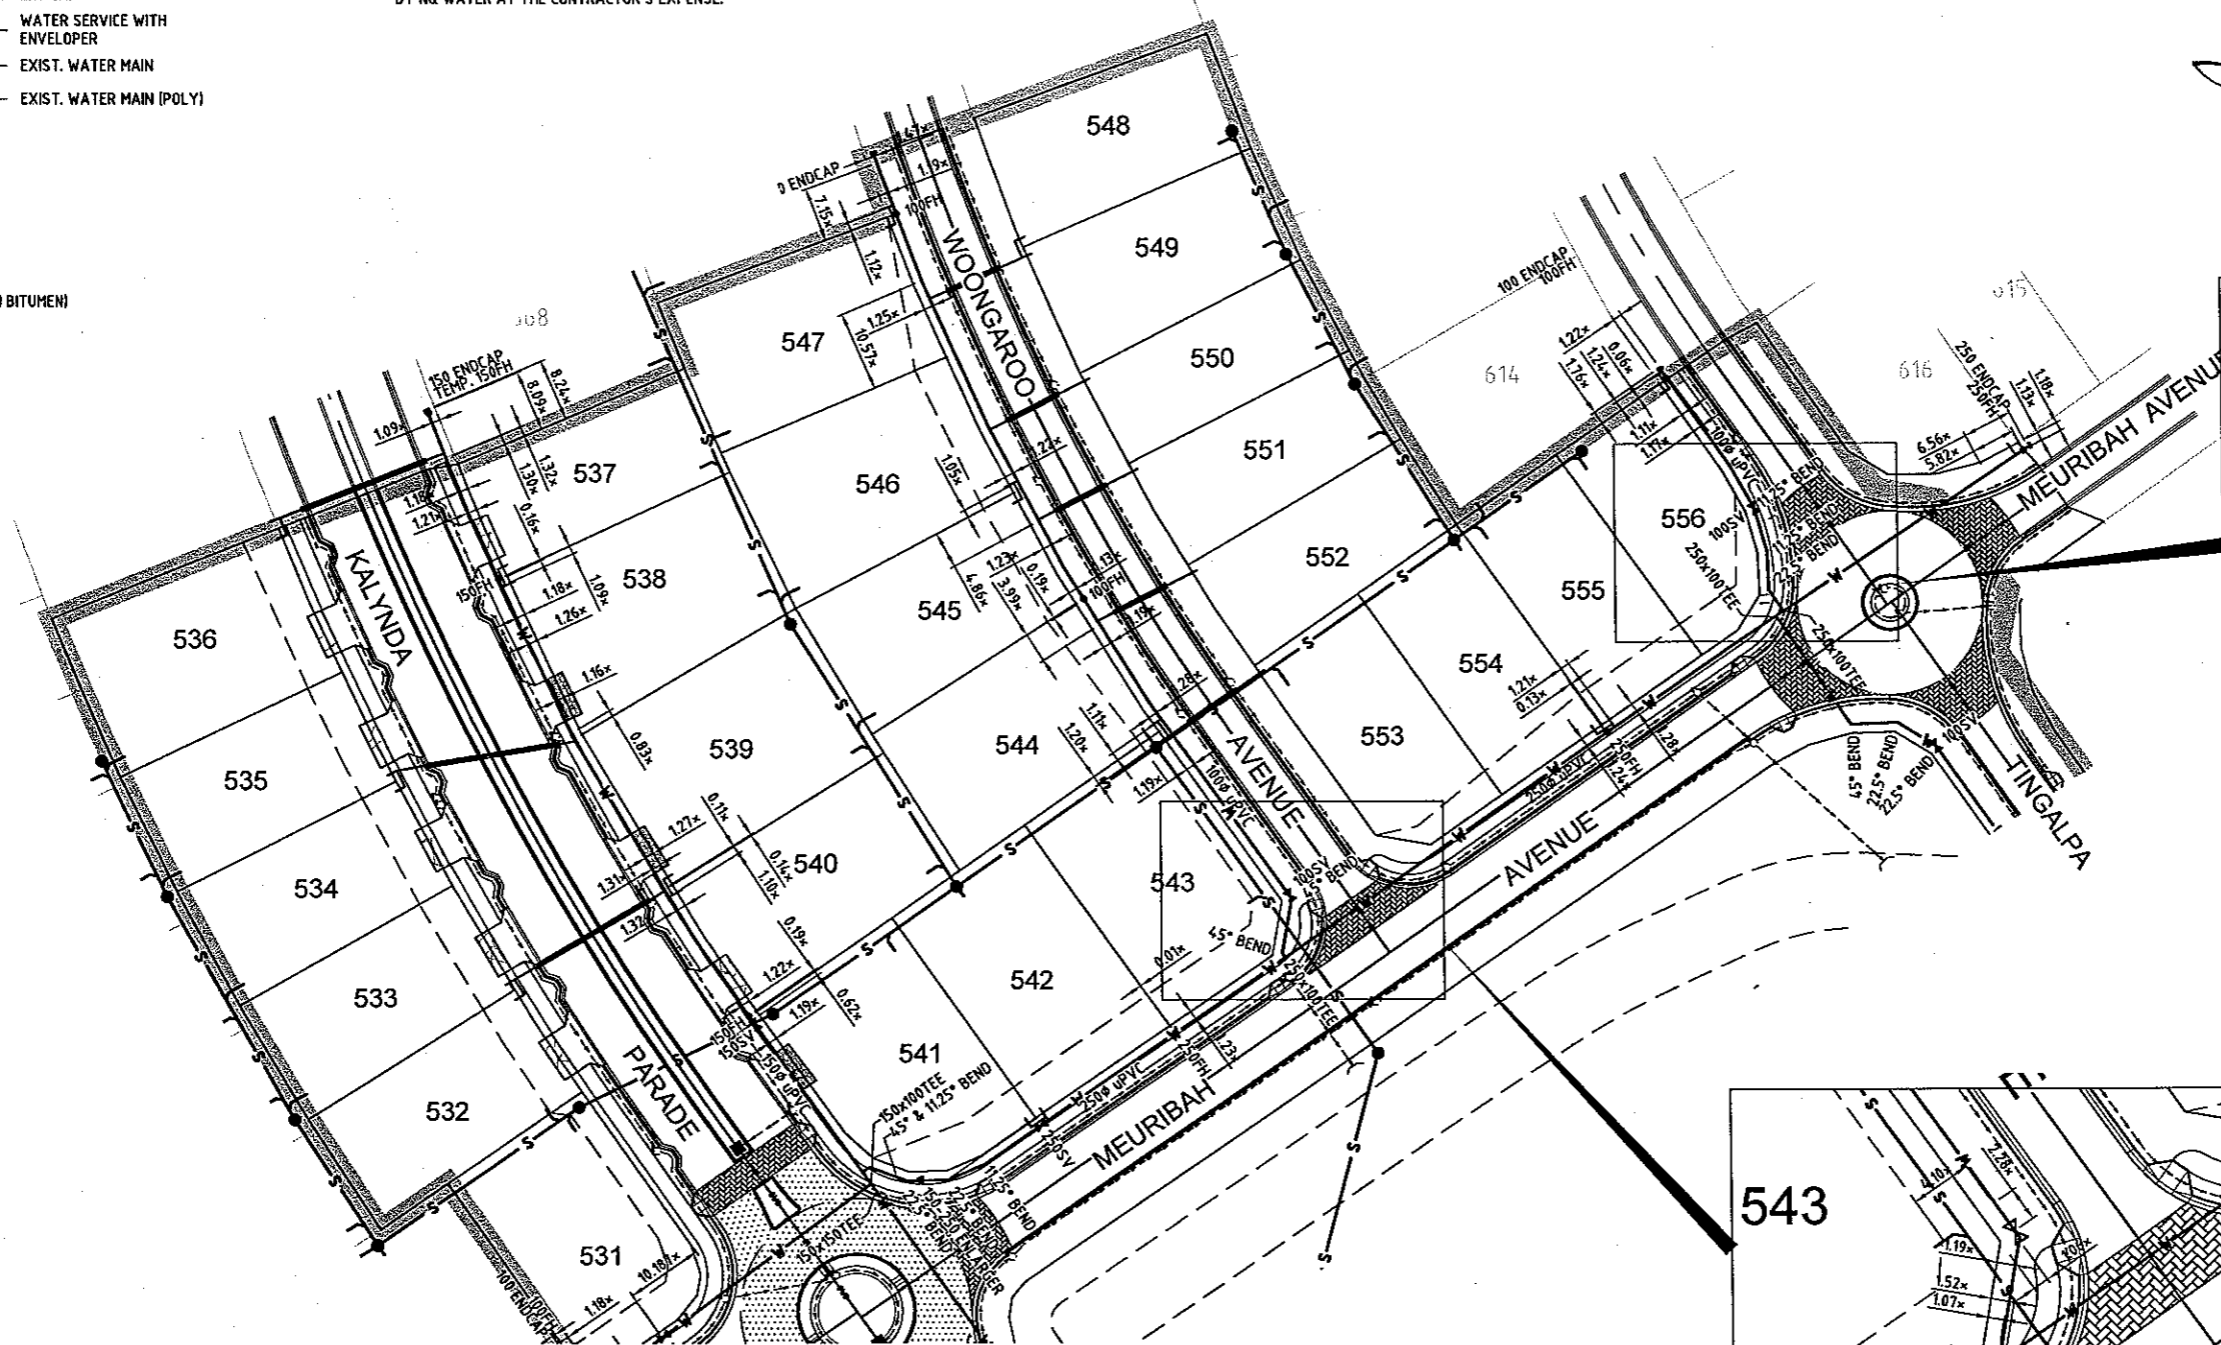

FOR CONTINUATION REFER DWG CT-1403-215

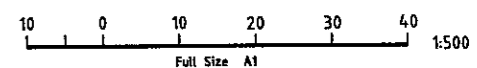

Date: 20/07/2008 14:57 PM
 User: ALEXIS@BMDL
 File Name: J:\CT-1403 - Kalynda Chase Stage 5B\1. Stage 5B\Drawings\Kalynda Stage 5B\A1\DWG-1403-215.dwg
 Plot Date: 20/07/2008 14:57 PM

No.	Amendments	By	Appd	Date	No.	Amendments	By	Appd	Date
A	ORIGINAL ISSUE		AM	22.07.08					



BMD CONSULTING
 Civil Engineers
 Structural Engineers
 & Project Managers
 AIN 23 010 743 682

Townsville Office: 57 Mitchell Street, Townsville, P.O. Box 4008, Townsville MC, QLD 4810
 Phone: (07) 4754 7000, Fax: (07) 4754 7077, Email: bmd.com.au@bmd.com.au, www.bmd.com.au

Head Office - Brisbane: 57 Mitchell Street, Brisbane, QLD 4000
 Phone: (07) 3893 1511

Sydney Office: 100 Pitt Street, Sydney, NSW 2000
 Phone: (02) 9898 5400

Cairns Office: 100 Mitchell Street, Cairns, QLD 4878
 Phone: (07) 4035 1544

Design	AM
Drawn	JL
Checked	JL
Original Approved By:	<i>[Signature]</i>
RPEQ No.	5748
Date	JULY 2008

Client: URBEX PTY LTD
Project: KALYND A STAGE 5B
Title: WATER RETICULATION PLAN SHEET 2 OF 2

AS CONSTRUCTED
 Drawing No. CT-1403-215 Rev A

THIS DRAWING CANNOT BE COPIED OR REPRODUCED IN ANY FORM OR USED FOR ANY OTHER PURPOSE OTHER THAN THAT ORIGINALLY INTENDED WITHOUT THE WRITTEN PERMISSION OF BMD CONSULTING PTY LTD.