
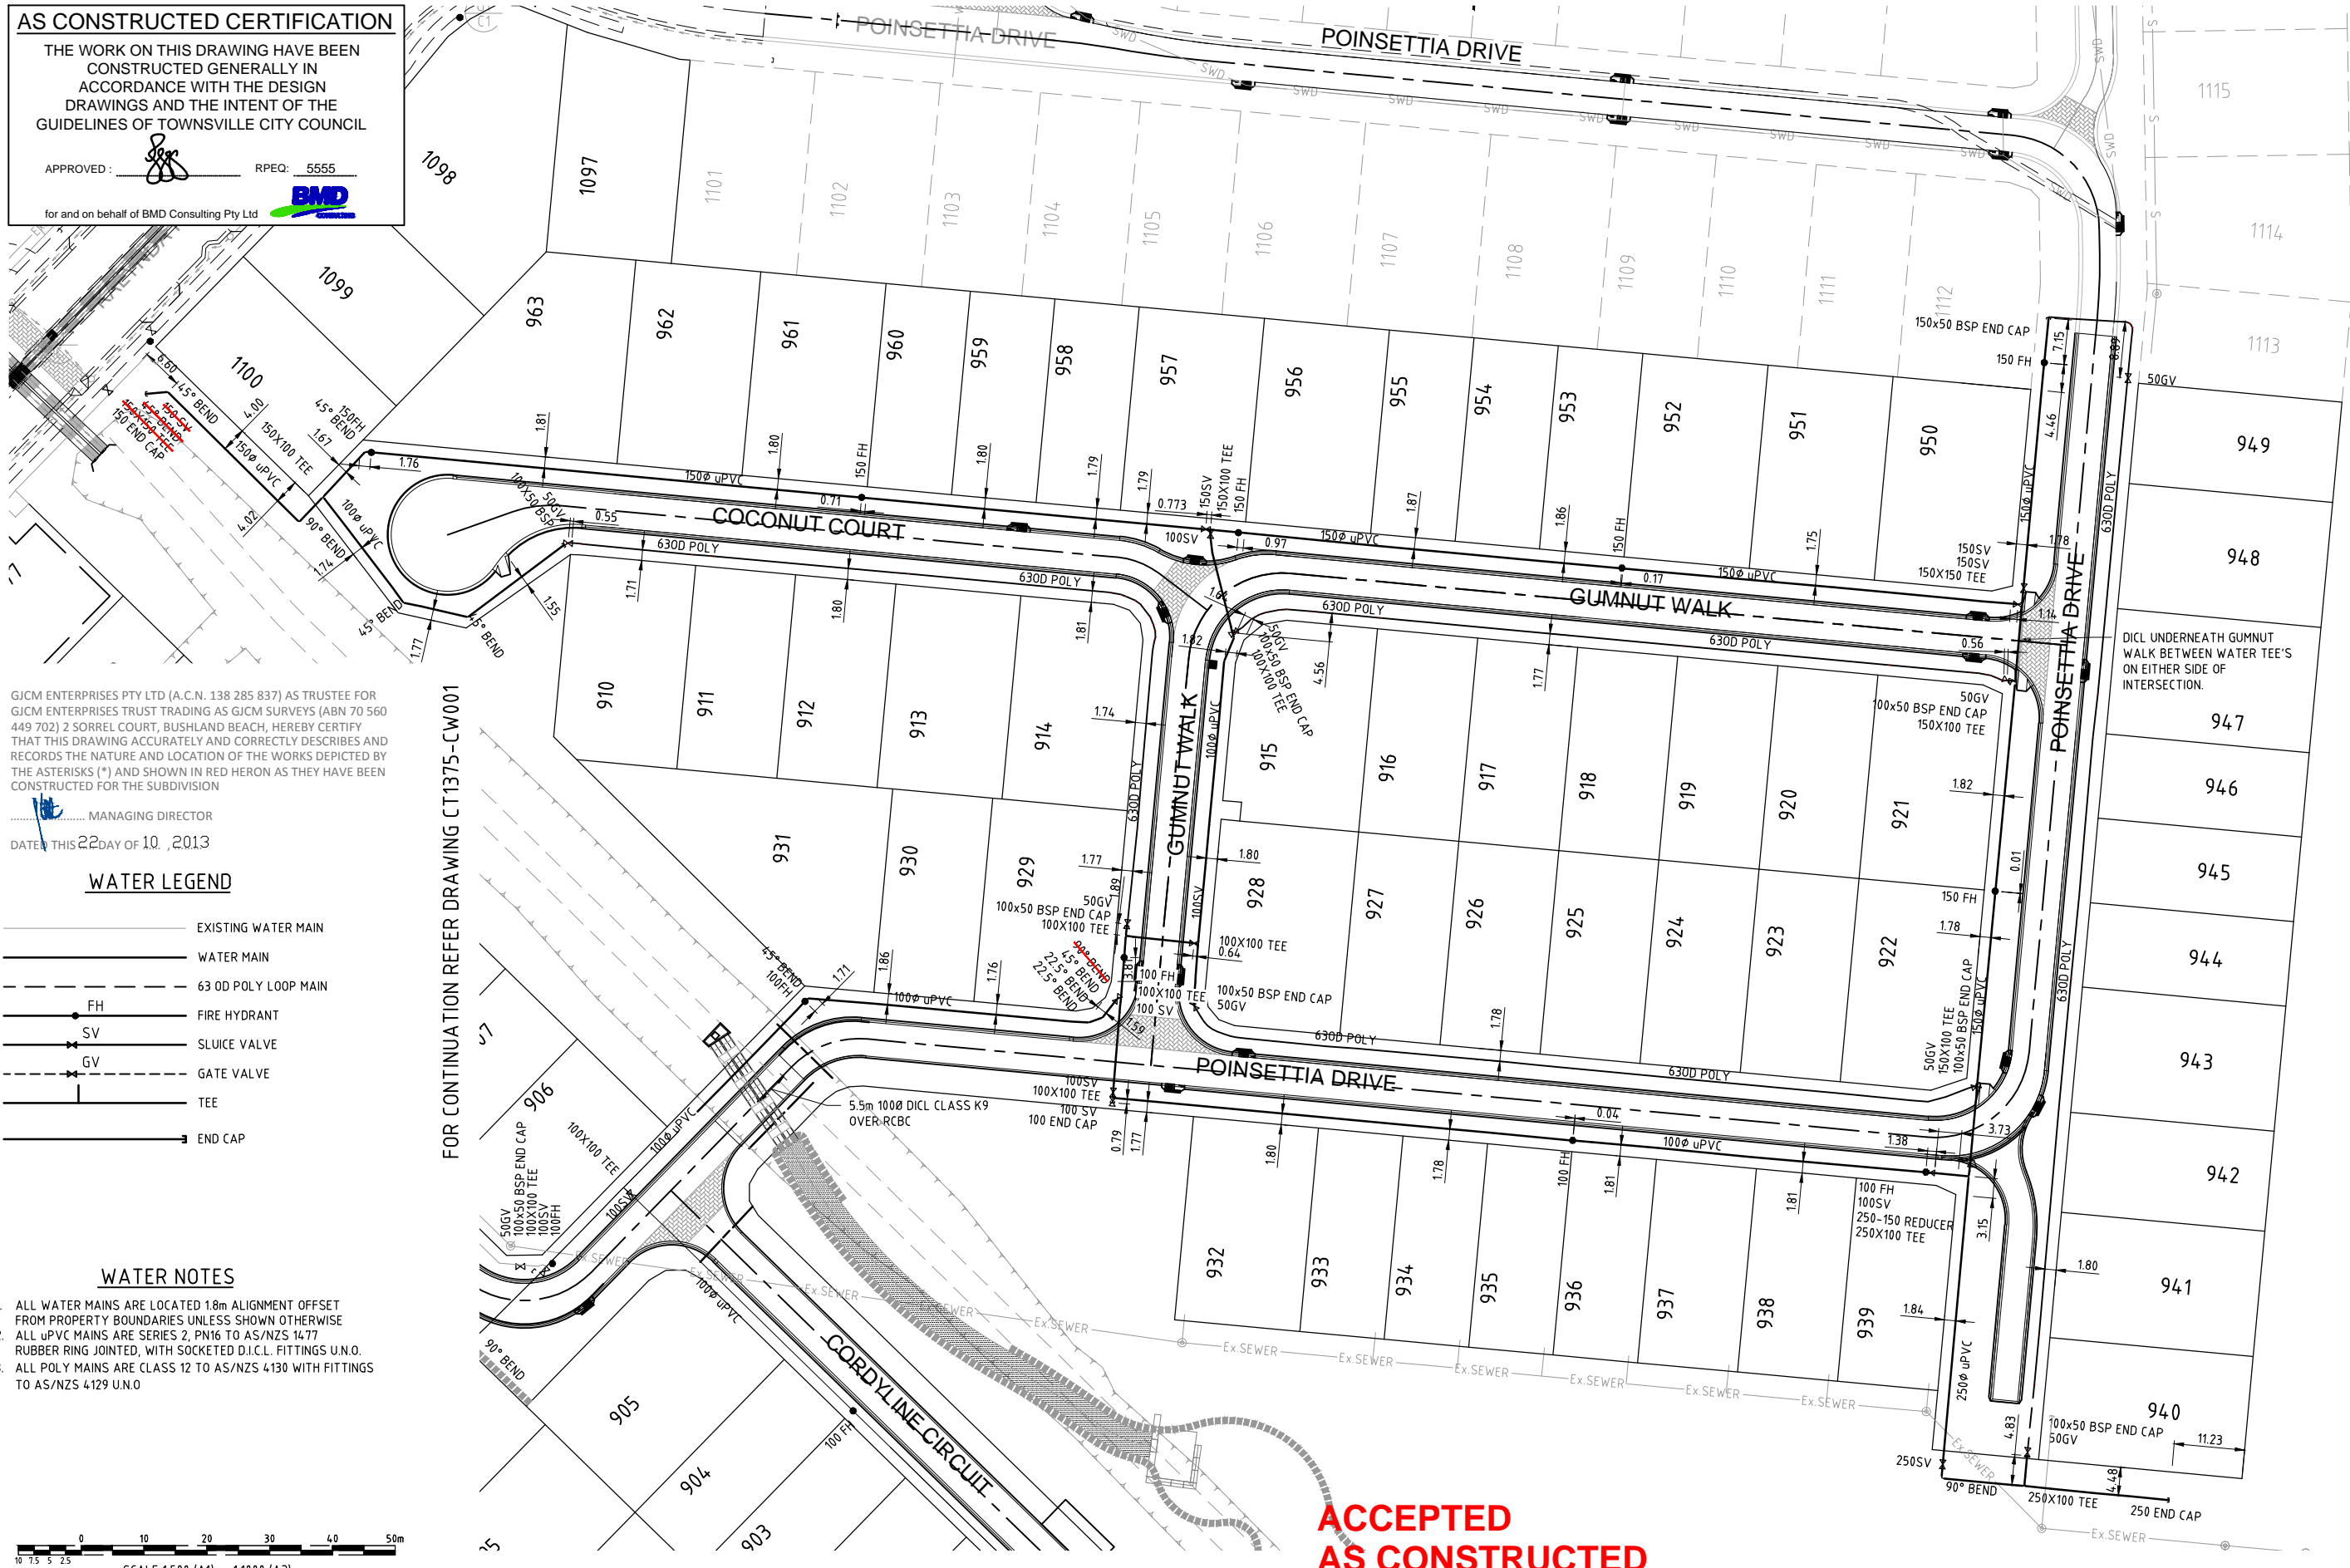


AS CONSTRUCTED CERTIFICATION

THE WORK ON THIS DRAWING HAVE BEEN CONSTRUCTED GENERALLY IN ACCORDANCE WITH THE DESIGN DRAWINGS AND THE INTENT OF THE GUIDELINES OF TOWNSVILLE CITY COUNCIL

APPROVED:  RPEQ: 5555






 


for and on behalf of BMD Consulting Pty Ltd 



GJCM ENTERPRISES PTY LTD (A.C.N. 138 285 837) AS TRUSTEE FOR GJCM ENTERPRISES TRUST TRADING AS GJCM SURVEYS (ABN 70 560 449 702) 2 SORREL COURT, BUSHLAND BEACH, HEREBY CERTIFY THAT THIS DRAWING ACCURATELY AND CORRECTLY DESCRIBES AND RECORDS THE NATURE AND LOCATION OF THE WORKS DEPICTED BY THE ASTERISKS (*) AND SHOWN IN RED HERON AS THEY HAVE BEEN CONSTRUCTED FOR THE SUBDIVISION

MANAGING DIRECTOR
DATED THIS 22 DAY OF 10, 2013

WATER LEGEND

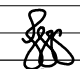
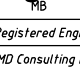
-  EXISTING WATER MAIN
-  WATER MAIN
-  63 OD POLY LOOP MAIN
-  FIRE HYDRANT
-  SLUICE VALVE
-  GATE VALVE
-  TEE
-  END CAP

WATER NOTES

1. ALL WATER MAINS ARE LOCATED 1.8m ALIGNMENT OFFSET FROM PROPERTY BOUNDARIES UNLESS SHOWN OTHERWISE
2. ALL uPVC MAINS ARE SERIES 2, PN16 TO AS/NZS 1477 RUBBER RING JOINTED, WITH SOCKETED D.I.C.L. FITTINGS U.N.O.
3. ALL POLY MAINS ARE CLASS 12 TO AS/NZS 4130 WITH FITTINGS TO AS/NZS 4129 U.N.O

FOR CONTINUATION REFER DRAWING CT1375-CW001

ACCEPTED AS CONSTRUCTED

No.	Amendments	Drawn	Design	Appd	Registered Engineer	Reg No.	Date
B	PROPERTY BOUNDARY OFFSETS ADDED	JK	JK	CH		5555	30/10/13
A	AS CONSTRUCTED	JK	JK	CH		5555	22/10/13



BMD consulting
 3rd Floor, 87 Mitchell Street North, Queensland 4850
 20 Ross Street, Townsville QLD 4780
 P: 07 4780 7000 F: 07 4780 7077
 E: townsville@bmd.com.au
 www.bmd.com.au
 ABN 28 008 749 002

Civil Engineers • Structural Engineers • Project Managers • Water Services Co-ordinators
 Brisbane • Cairns • Coolum • Gladstone • Gold Coast • Mackay • Sydney • Townsville

Client	URBEX PTY LTD	Datum	AHD
Project	KALYNDA CHASE STAGE 10B	PSM	131651
Title	WATER RETICULATION LAYOUT PLAN	RL	19.248
		(MGA) COORD	
		AS CONSTRUCTED	
Project No.	CT1375-CW102	Drawing No.	
		Rev	B

File Name: B:\urbex - Consulting\URBEX\REGIONAL TOWNSVILLE\CT-1375 - Kalynnda Chase Stage 10B Drawings\AS Con Stage 10B\CT-1375-AS CON-MAP

This drawing cannot be copied or reproduced in any form or used for any purpose other than that originally intended without the written permission of BMD Consulting Pty Ltd. © COPYRIGHT 2013