



BRAZIER MOTTI PTY LTD. ACN 066 411 041
 595 FLINDERS ST. TOWNSVILLE, HEREBY CERTIFY THAT
 THIS DRAWING ACCURATELY AND CORRECTLY DESCRIBES
 AND RECORDS THE NATURE AND LOCATION OF THE WORKS
 DEPICTED BY ASTERISKS (*) HEREON AS THEY HAVE BEEN
 CONSTRUCTED FOR SUBDIVISION.

[Signature] DIRECTOR
 LICENSED SURVEYOR & DIRECTOR

WATER LEGEND


- WATER MAIN
- 63 OD POLYETHYLENE LOOP MAIN
- FH — FIRE HYDRANT
- SV — SLUICE VALVE
- GV — GATE VALVE
- TEE
- END CAP
- WATER SERVICE WITH ENVELOPER
- Ex. WATER — EXIST. WATER MAIN
- Ex. WATER (POLY) — EXIST. WATER MAIN (POLY)
- LIMIT OF WORKS - STAGE 4

WATER NOTES

1. ALL WATER MAINS LOCATED 1.2m ALIGNMENT OFFSET FROM PROPERTY BOUNDARIES UNLESS SHOWN OTHERWISE
2. THIS DRAWING IS TO BE READ IN CONJUNCTION WITH CITY OF TOWNSVILLE STANDARD DRAWINGS (WATER)
3. ALL PVC MAINS ARE SERIES 2, PN16 TO AS/NZS 1417 RUBBER RING JOINTED, WITH SOCKETED D.I.C.L. FITTINGS U.N.O.

DATUM

PM No. 131651 LOCATED ON
 HERVEY RANGE ROAD (BOLT IN BITUMEN)
 RL 19.246

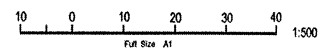

| No. | Original Issue | By | Appd | Date | No. | Amendments | By | Appd | Date |
|-----|----------------|--------|------|----------|-----|------------|----|------|------|
| A | ORIGINAL ISSUE | S.J.J. | | 25.07.07 | | | | | |
| | Amendments | | | | | | | | |

THIS DRAWING CANNOT BE COPIED OR REPRODUCED IN ANY FORM OR USED FOR ANY OTHER PURPOSE OTHER THAN THAT ORIGINALLY INTENDED WITHOUT THE WRITTEN PERMISSION OF BMD CONSULTING PTY LTD.



Civil Engineers
 Structural Engineers
 Project Managers
 ABN 23 010 743 992



Townsville Office
 57 Mitchell Street
 Townsville
 P.O. Box 9008
 Townsville QLD 4810
 Ph: (07) 4780 7020
 Fax: (07) 4780 7077
 Email: townsville@bmd.com.au
 Website: www.bmd.com.au

Head Office - Brisbane
 Ph: (07) 3460 1811
 Email: brisbane@bmd.com.au
 Ph: (07) 4036 1544

Gold Coast Office
 Ph: (07) 5569 5400

| | |
|-----------------------|---------|
| Design | S.J.J. |
| Drawn | W.E.E. |
| Checked | |
| Original Approved By: | |
| RPEQ No. | 346 |
| Date | JULY 07 |
| Datum | A.H.D. |

| | |
|---------|--------------------------------|
| Client | URBEX Pty Ltd |
| Project | KALYNDIA CHASE - STAGE 4A |
| Title | WATER RETICULATION LAYOUT PLAN |

AS CONSTRUCTED
 Drawing No. CT-1173-203
 Rev A