

FOR CONTINUATION REFER DRAWING CT-1560-110

**WATER LEGEND**

- WATER MAIN
- FIRE HYDRANT
- SLUICE VALVE
- GATE VALVE
- TEE
- END CAP
- WATER SERVICE WITH ENVELOPER
- EXIST. WATER MAIN
- PROPOSED SEWER MAIN
- EXIST. SEWER MAIN


**WATER NOTES**

1. ALL WATER MAIN WORKS WERE CONSTRUCTED IN ACCORDANCE WITH COUNCIL'S AUSSPEC
1. ALL WATER MAINS LOCATED 1.2m ALIGNMENT OFFSET FROM PROPERTY BOUNDARIES UNLESS SHOWN OTHERWISE
2. ALL uPVC MAINS ARE SERIES 2, PN16 TO AS/NZS 1477 RUBBER RING JOINTED, WITH SOCKETED O.I.C.L. FITTINGS U.N.O.
3. CONNECTION TO EXISTING TOWNSVILLE CITY COUNCIL WATER MAINS WERE CARRIED OUT BY THE CONTRACTOR UNDER COUNCIL SUPERVISION
4. CONNECTION TO EXISTING NO WATER MAINS WERE CARRIED OUT BY NO WATER AT THE CONTRACTOR'S EXPENSE.
5. CONTRACTOR VERIFIED ALL UNDERGROUND SERVICES WITH THE RELEVANT AUTHORITIES PRIOR TO ANY EXCAVATION

BRAZIER MOTTI PTY LTD. ACN 066 411 041  
 595 FLINDERS ST. TOWNSVILLE, HEREBY CERTIFY THAT THIS DRAWING ACCURATELY AND CORRECTLY DESCRIBES AND RECORDS THE NATURE AND LOCATION OF THE WORKS DEPICTED BY ASTERISKS (\*) HEREON AS THEY HAVE BEEN CONDUCTED FOR SUPERVISION.  
 COMMON DIRECTOR  
 LICENSED SURVEYOR & DIRECTOR  
 Dated This 17 day of 12, 2009  
 SEAL OF BRAZIER MOTTI PTY LTD. ACN 066 411 041

**DATUM**

PM No.131651 LOCATED ON HERVEY RANGE ROAD (BOLT IN BITUMEN) RL 19.248m AHD

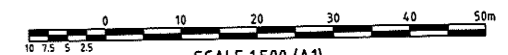

SCALE 1:500 (A1)  
 DO NOT SCALE, USE ONLY THE DIMENSIONS PROVIDED

FOR CONTINUATION REFER DRAWING CT-1560-110

User: STRATTON, JACOBS/RE: JACT-1560 - 1560/CT-1560 - Kalynda Chase Stage 6B/1560 - 1560/CT-1560 - AS CON-1560 - AS CON-1560

No.	Amendments	Drawn	Design	Appd	Certified	Reg No.	Date
A	ORIGINAL ISSUE	S.J.J.	E.J.C.			5968	17.12.09

1st Floor,  
 57 Mitchell Street North Ward QLD 4810  
 PO Box 6008 Townsville MC QLD 4810  
 P: 07 4750 7000 F: 07 4750 7077  
 E: townsville@bmd.com.au  
 www.bmd.com.au  
 ABN 23 010 743 692

Client	URBEX PTY LTD	Datum	AHD		
Project	KALYNDA STAGE 6B	PSM	131651		
Title	WATER RETICULATION LAYOUT PLAN (SHEET 2 OF 2)	RL	19.248		
		AS	CONSTRUCTED		
		Project No.	CT-1560-111	Rev	A

This drawing cannot be copied or reproduced in any form or used for any purpose other than that originally intended without the written permission of BMD Consulting Pty Ltd. © COPYRIGHT 2009